DEPARTMENT OF GENERAL SERVICES BUREAU OF CAPITAL PROJECT DESIGN MANAGEMENT 1800 HERR STREETS HARRISBURG, PENNSYLVANIA

ADDENDUM NO. 2

on

PROJECT NO. DGS C-0404-0034 PHASE 001 PROJECT TITLE - McKeever Environmental Center Demolition Project PROFESSIONAL: KCI Assoc. of Ohio 441 Wolf Ledges Pkwy Akron, HI, 44311

If you submitted a bid prior to this Addendum being issued, your bid has been discarded and you <u>must re-submit your bid(s)</u> prior to the bid opening date and time.

GENERAL CHANGES - ALL CONTRACTS

Item 1 - Design Build Contractor is to work with DCNR and PHMC during the design build process to locate and erect a kiosk to reference buildings that were removed during demolition. The kiosk style and information contained within it will be determined by PHMC, who will be working in conjunction with DCNR and DGS during the project.


Item 2 - Existing water line to be repaired, that is noted on plans, is 2" in diameter.

SPECIFICATION CHANGES – ALL CONTRACTS

Item 1 - N/A

DRAWING CHANGES - ALL CONTRACTS

Item 1 - Page C-2 February 2023 (attached), will replace Page C-2 from original plan package. This page now notes that the shed located outside the maintenance building is to be removed with the other debris located along the surrounding tree line at this location. The shed contains signs and miscellaneous wood used for repairs by the facility.

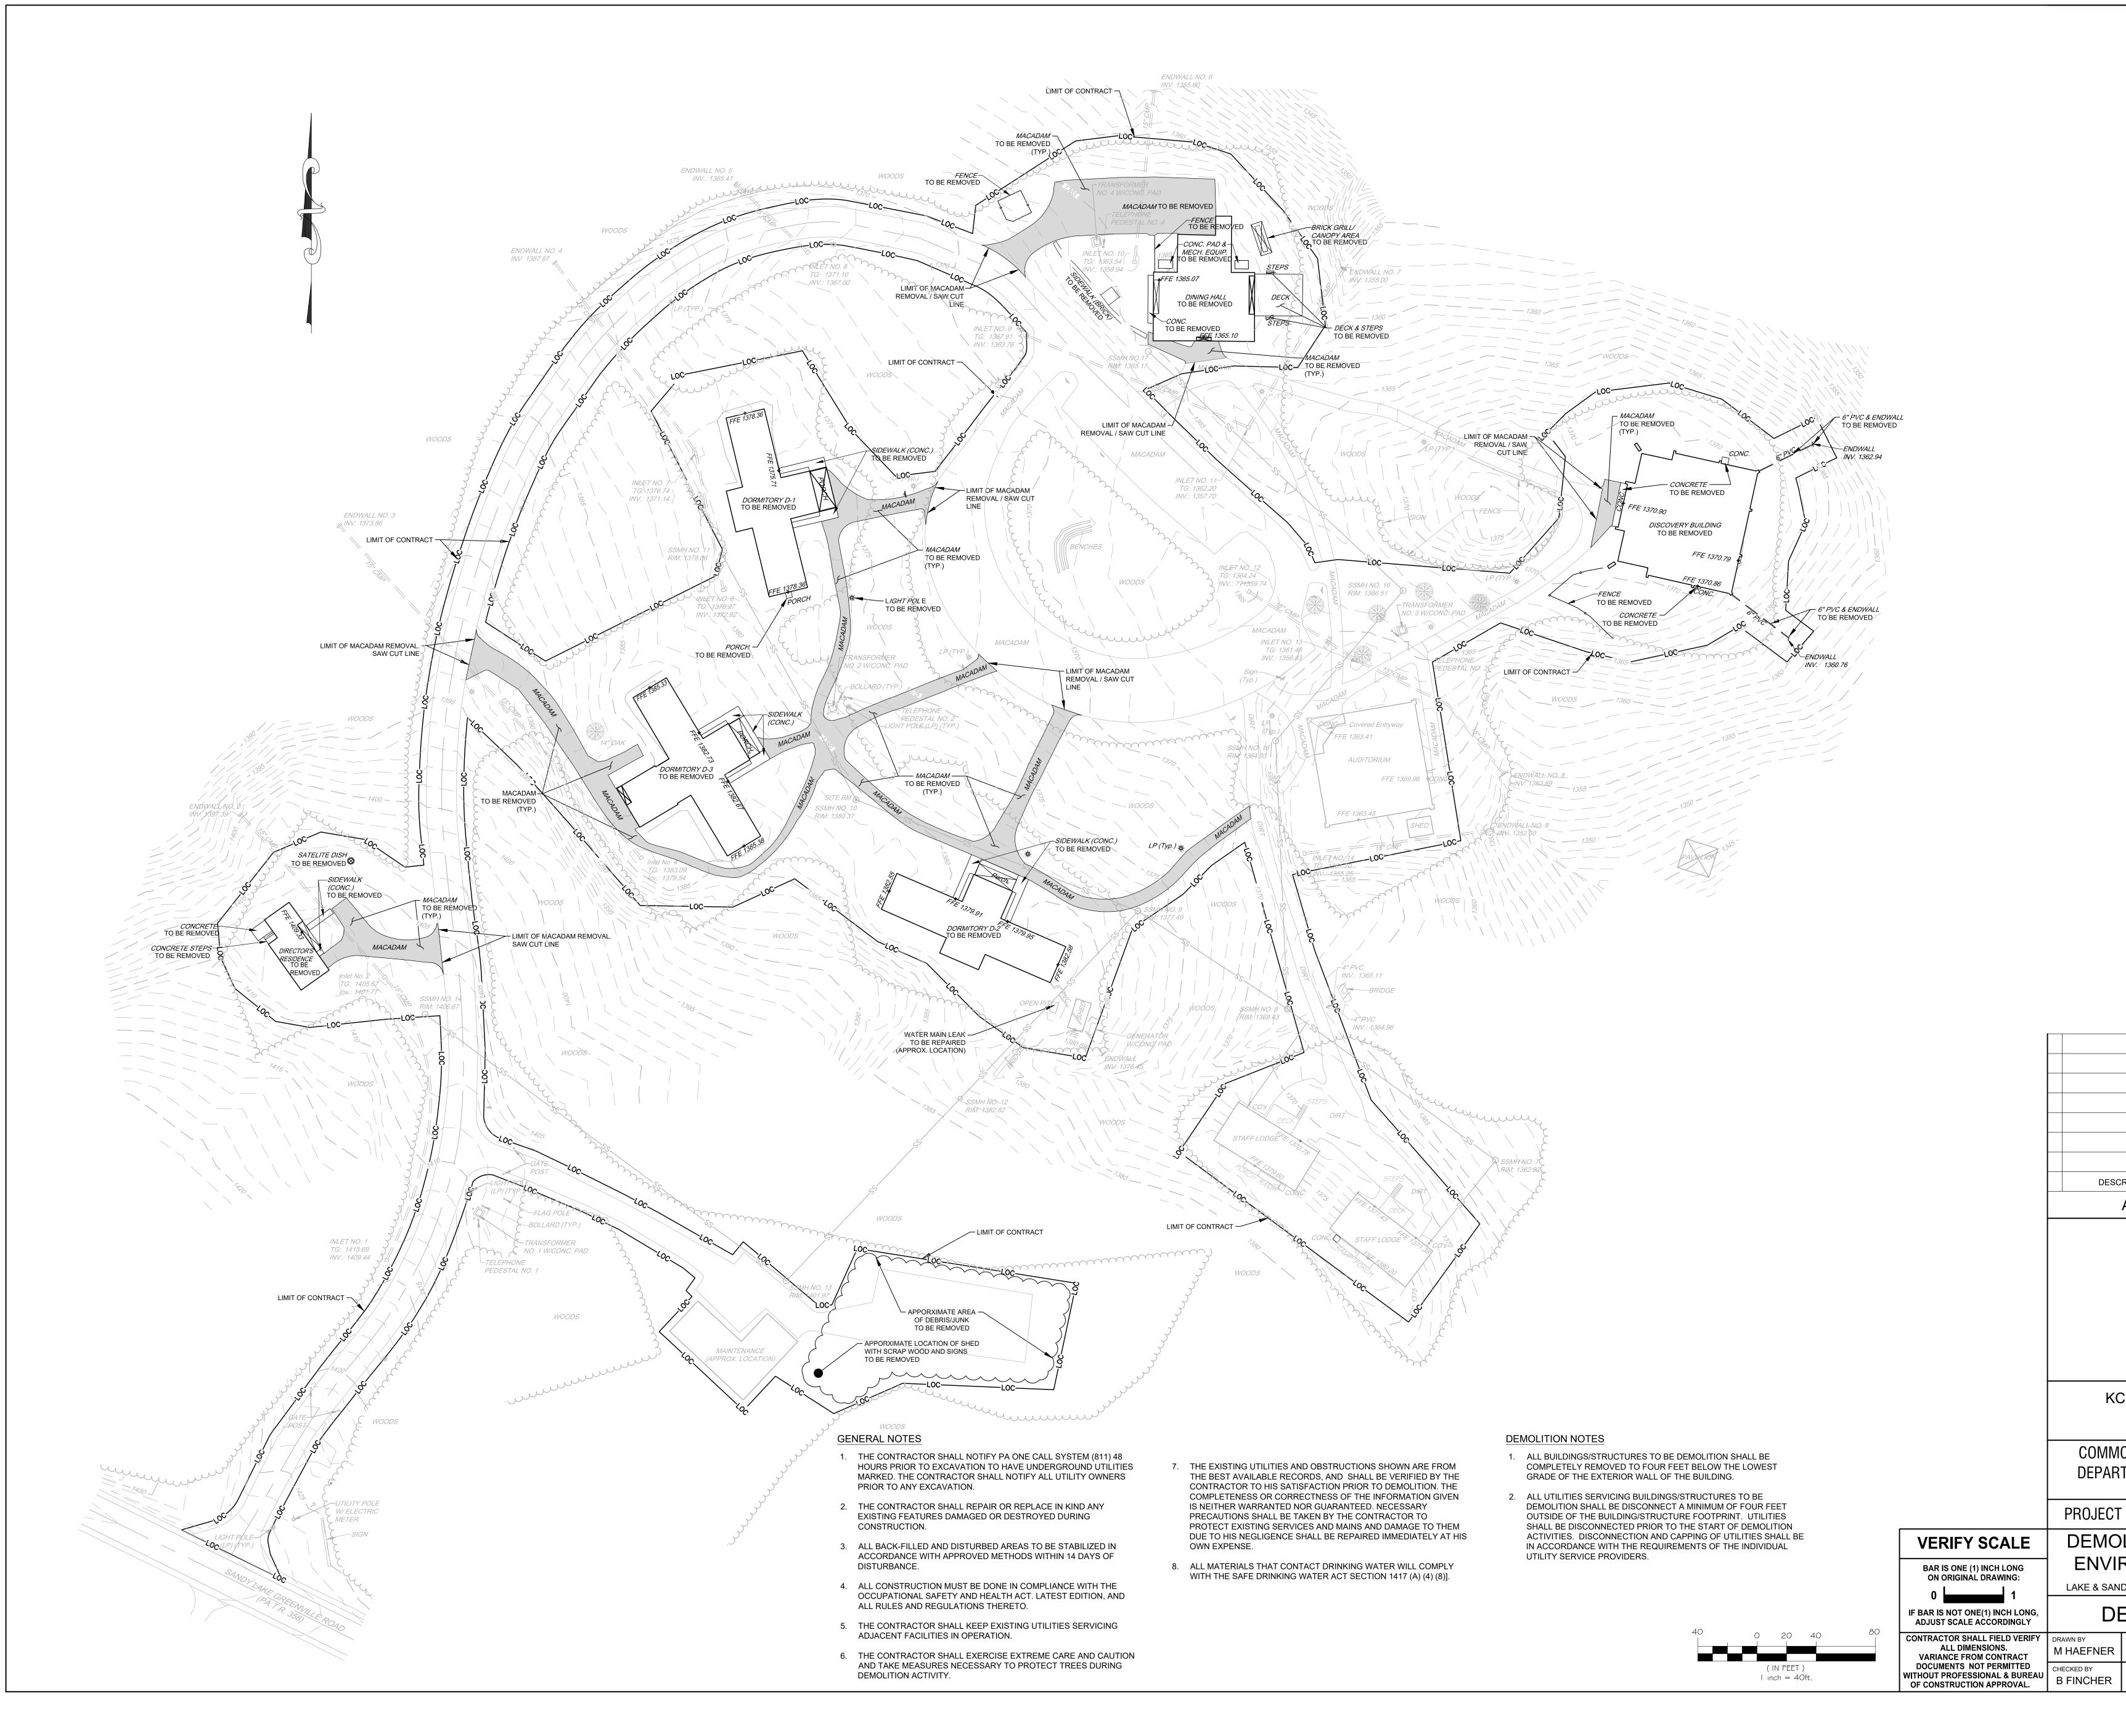

		DESCRIPTION
AS-BUILT REVISIONS		
PROFESSIONAL'S SIGNATURE Date		
CI TECHNOLOGIES, INC.		
5001 LOUISE DRIVE, SUITE 201		
MECHANICSBURG, PA		
ONWEALTH OF PENNSYLVANIA		
TMENT OF GENERAL SERVICES		
HARRISBURG, PENNSLYVANIA		
NO. DGS 0404-0034, PHASE 001		
LITION OF MCKEEVER		
RONMENTAL CENTER		
DY LAKE TOWNSHIPS, MERCER COUNTY, PA		
EMOLITION PLAN		
	DR.	AWING NO.
FEB 2023		C-2
1" = 40'		
-		