


COMMONWEALTH OF PENNSYLVANIA DEPARTMENT OF CONSERVATION AND NATURAL RESOURCES OFFICE OF PARKS AND FORESTRY BUREAU OF STATE PARKS

100% SUBMISSION


PROJECT: FDC-133-4494

THE INN AT BALD EAGLE STATE PARK HOWARD AND LIBERTY TOWNSHIP, CENTRE COUNTY PENNSYLVANIA


CONTRACT NO'S
GENERAL FDC-133-4494.1
HVAC FDC-133-4494.2
PLUMBING FDC-133-4494.3
ELECTRICAL FDC-133-4494.4
ROADWORK FDC-133-4494.5

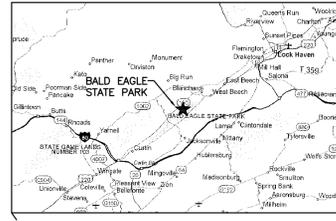

BALD EAGLE STATE PARK
149 MAIN PARK ROAD
HOWARD, PA 16841
(814) 625-2775

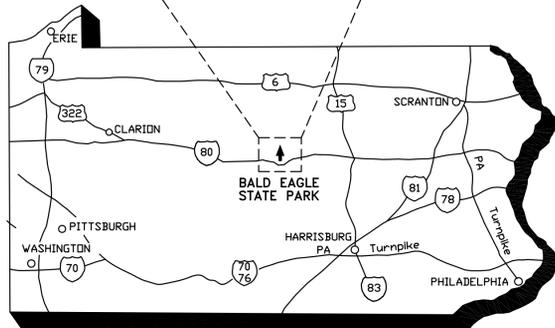

PARK LOCATION MAP
N.T.S.

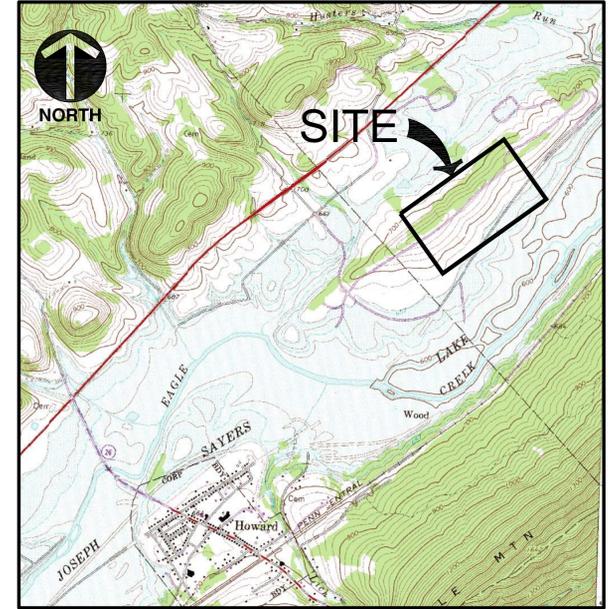

REFERENCE:
U.S.G.S. 7.5' TOPOGRAPHIC MAP, HOWARD QUADRANGLE, PENNSYLVANIA, DATED 1967.
PHOTOREVISED 1973.

LOCATION MAP
SCALE: 1"=2000'

AS-BUILT
THIS RECORD DRAWING HAS BEEN PREPARED ON INFORMATION PROVIDED BY OTHERS. THE DESIGN PROFESSIONAL HAS NOT VERIFIED THE ACCURACY AND/OR COMPLETENESS OF THIS INFORMATION AND SHALL NOT BE RESPONSIBLE FOR ANY ERRORS OR OMISSIONS WHICH MAY BE INCORPORATED HEREIN AS A RESULT.

PREPARED BY:
CIVIL & ENVIRONMENTAL CONSULTANTS, INC. (CEC)
AND
DEPARTMENT OF CONSERVATION AND NATURAL RESOURCES
OFFICE OF PARKS AND FORESTRY
BUREAU OF FACILITY DESIGN AND CONSTRUCTION
400 MARKET STREET, HARRISBURG, PA 17101

APPROVED:

JOHN NORBECK
DIRECTOR, BUREAU OF STATE PARKS



EDWARD G. RENDELL

GOVERNOR

MICHAEL DiBERARDINIS





SECRETARY, DEPARTMENT OF CONSERVATION
AND NATURAL RESOURCES

DWG NO.	DRAWING INDEX	BUILDING	CONTRACT NO: FDC-133-4494				
			.1	.2	.3	.4	.5
CS	COVER SHEET	NATURE INN	X	X	X	X	X
C1.0	OVERALL EXISTING CONDITIONS / DEMOLITION PLAN	NATURE INN	X				
C1.1	SIGNAGE PLAN	NATURE INN	X				
C2.0	OVERALL LAYOUT PLAN	NATURE INN	X				
C2.1	ENLARGED LAYOUT PLAN	NATURE INN	X	X	X		
C2.2	ENLARGED LAYOUT PLAN	NATURE INN	X				
C3.0	OVERALL GRADING PLAN	NATURE INN	X				
C3.1	ENLARGED GRADING PLAN	NATURE INN	X				
C3.2	ENLARGED GRADING PLAN	NATURE INN	X				
C4.0	ENLARGED DRAINAGE PLAN	NATURE INN	X	X			
C4.1	ENLARGED DRAINAGE PLAN	NATURE INN	X				
C5.0	ENLARGED UTILITY PLAN & DETAILS	NATURE INN	X	X	X		
C5.1	ENLARGED UTILITY PLAN	NATURE INN	X		X		
C5.2	OVERALL UTILITY PLAN	NATURE INN	X		X		
C7.0	OVERALL LANDSCAPE PLAN	NATURE INN	X				
C7.1	ENLARGED LANDSCAPE PLAN	NATURE INN	X				
C7.2	ENLARGED LANDSCAPE PLAN	NATURE INN	X				
C8.0	CONSTRUCTION DETAILS	NATURE INN	X				
C8.1	CONSTRUCTION DETAILS	NATURE INN	X				
C8.2	CONSTRUCTION DETAILS	NATURE INN	X				
C8.3	CONSTRUCTION DETAILS	NATURE INN	X		X		
C8.4	CONSTRUCTION DETAILS	NATURE INN	X				
C8.5	CONSTRUCTION DETAILS	NATURE INN	X		X		
C8.6	CONSTRUCTION DETAILS	NATURE INN	X	X			
C8.7	RADON MITIGATION SYSTEM DETAILS	NATURE INN	X				
C9.0	OVERALL EROSION & SEDIMENTATION CONTROL PLAN	NATURE INN	X				
C9.1	OVERALL EROSION & SEDIMENTATION CONTROL PLAN	NATURE INN	X				
C9.2	ENLARGED EROSION & SEDIMENTATION CONTROL PLAN	NATURE INN	X				
C9.3	ENLARGED EROSION & SEDIMENTATION CONTROL PLAN	NATURE INN	X				
C9.4	EROSION AND SEDIMENTATION CONTROL NOTES	NATURE INN	X				
C9.5	EROSION AND SEDIMENTATION CONTROL DETAILS	NATURE INN	X				

DWG NO.	DRAWING INDEX	BUILDING	CONTRACT NO: FDC-133-4494				
			.1	.2	.3	.4	.5
ARCHITECTURAL							
A0.0	GENERAL NOTES, ABBREVIATIONS, REFERENCE SYMBOLS, KEY PLANS	NATURE INN	X	103	10	10	
A0.1	BUILDING CODE INFORMATION	NATURE INN	X	31	31	31	31
A2.0	BASEMENT LEVEL FLOOR PLAN	NATURE INN	X	033	03	03	03
A2.1	LOWER LEVEL FLOOR PLAN	NATURE INN	X				
A2.2	UPPER LEVEL FLOOR PLAN	NATURE INN	X				
A2.3	ROOF PLAN	NATURE INN	X				
A3.0	EXTERIOR ELEVATIONS	NATURE INN	X				
A3.1	EXTERIOR ELEVATIONS ENLARGED	NATURE INN	X	X			
A3.2	EXTERIOR ELEVATIONS ENLARGED	NATURE INN	X	X			
A3.3	BUILDING SECTIONS	NATURE INN	X	X			
A3.4	BUILDING SECTIONS	NATURE INN	X				
A3.5	BUILDING SECTIONS	NATURE INN	X				
A4.0	ENLARGED PLANS AND ELEVATIONS	NATURE INN	X	X	X	X	
A4.1	ENLARGED PLANS AND ELEVATIONS	NATURE INN	X	X	X	X	
A5.0	INTERIOR ELEVATIONS - LOWER LEVEL	NATURE INN	X	X	X		
A5.1	INTERIOR ELEVATIONS - LOWER LEVEL	NATURE INN	X	X	X		
A5.2	INTERIOR ELEVATIONS - UPPER LEVEL	NATURE INN	X	X	X		
A6.0	RCP BASEMENT	NATURE INN	X	X	X	X	
A6.1	RCP LOWER LEVEL	NATURE INN	X	X	X	X	
A6.2	RCP UPPER LEVEL	NATURE INN	X	X	X	X	
A7.0	STAIR PLANS AND SECTIONS	NATURE INN	X				
A7.1	STAIR DETAILS	NATURE INN	X				
A7.2	LU/LA ELEVATOR AND CHUTES PLANS AND SECTIONS	NATURE INN	X		X		
A8.0	WALL SECTIONS AND EXTERIOR DETAILS	NATURE INN	X				
A8.1	WALL SECTIONS AND EXTERIOR DETAILS	NATURE INN	X				
A8.2	WALL SECTIONS AND EXTERIOR DETAILS	NATURE INN	X				
A8.3	WALL SECTIONS AND EXTERIOR DETAILS	NATURE INN	X				
A8.4	FIREPLACE AND CHIMNEY DETAILS	NATURE INN	X				
A8.5	FIREPLACE AND CHIMNEY DETAILS	NATURE INN	X				
A8.6	PLAN DETAILS	NATURE INN	X				
A8.7	SECTION DETAILS	NATURE INN	X				
A8.8	ROOF DETAILS	NATURE INN	X				
A8.9	GLUED LAM TRUSS DETAILS	NATURE INN	X				
A9.0	SCHEDULES AND WINDOW TYPES	NATURE INN	X				
A9.1	DOOR SCHEDULE, TYPES AND DETAILS	NATURE INN	X				
A9.2	WINDOW AND DOOR DETAILS	NATURE INN	X				
A9.3	FLOOR CEILING AND THRESHOLD DETAILS	NATURE INN	X				
A10.1	TYPICAL INTERIOR DETAILS	NATURE INN	X				
A10.2	INTERIOR DETAILS	NATURE INN	X				
A10.3	SIGNAGE	NATURE INN	X	X			
A10.4	LOBBY TILE LAYOUT	NATURE INN	X				
FFE2.1	LOWER LEVEL FURNITURE PLAN (FOR REF. ONLY)	NATURE INN	X				
FFE2.2	UPPER LEVEL FURNITURE PLAN (FOR REF. ONLY)	NATURE INN	X				

DWG NO.	DRAWING INDEX	BUILDING	CONTRACT NO: FDC-133-4494				
			.1	.2	.3	.4	.5
STRUCTURAL							
S0.1	GENERAL NOTES	NATURE INN	X				
S1.1	FOUNDATION/BASEMENT FLOOR PLAN	NATURE INN	X				
S1.2	FIRST FLOOR FRAMING/FOUNDATION PLAN	NATURE INN	X				
S1.3	UPPER FLOOR FRAMING PLAN	NATURE INN	X				
S1.4	ROOF FRAMING PLAN	NATURE INN	X				
S2.1	TYPICAL FOUNDATION DETAILS	NATURE INN	X				
S2.2	TYPICAL FRAMING DETAILS	NATURE INN	X				
S2.3	FOUNDATION SECTIONS AND DETAILS	NATURE INN	X				
S2.4	FRAMING SECTIONS AND DETAILS	NATURE INN	X				
S2.5	FRAMING SECTIONS AND DETAILS	NATURE INN	X				
S2.6	CONCRETE STAIR DETAILS	NATURE INN	X				
S2.7	DETAILS	NATURE INN	X				
HVAC							
M0.1	HVAC SCHEDULES, SYMBOLS, NOTES AND ABBREVIATIONS	NATURE INN		X	X	X	
M1.0	BASEMENT PLAN HVAC	NATURE INN		X	X		
M1.1	LOWER LEVEL FLOOR PLAN HVAC	NATURE INN		X	X		
M1.2	UPPER LEVEL FLOOR PLAN HVAC	NATURE INN		X	X		
M1.3	ROOF PLAN HVAC	NATURE INN		X			
M3.0	SECTIONS HVAC	NATURE INN		X			
M3.1	SECTIONS HVAC	NATURE INN		X			
M3.2	SECTIONS HVAC	NATURE INN		X			
M3.3	SECTIONS HVAC	NATURE INN		X			
M3.4	SECTIONS HVAC	NATURE INN		X			
M4.0	PIPING DIAGRAM HVAC	NATURE INN		X			
M5.0	DETAILS HVAC	NATURE INN		X			
PLUMBING							
P0.1	PLUMBING SCHEDULES, SYMBOLS, NOTES AND ABBREVIATIONS	NATURE INN				X	
P1.0	BASEMENT PLAN PLUMBING	NATURE INN				X	
P1.1	LOWER LEVEL FLOOR PLAN PLUMBING	NATURE INN				X	
P1.2	UPPER LEVEL FLOOR PLAN PLUMBING	NATURE INN				X	
P4.0	PLUMBING DETAILS	NATURE INN				X	
P4.1	PLUMBING DETAILS	NATURE INN				X	
P4.2	PLUMBING SECTIONS AND DETAILS	NATURE INN				X	
P4.3	PLUMBING SECTIONS	NATURE INN				X	
FIRE PROTECTION							
FP0.1	FIRE PROTECTION SYMBOLS, NOTES, DETAILS AND ABBREVIATIONS	NATURE INN				X	
FP1.0	BASEMENT PLAN FIRE PROTECTION	NATURE INN				X	
FP1.1	LOWER LEVEL FLOOR PLAN FIRE PROTECTION	NATURE INN				X	
FP1.2	UPPER LEVEL FLOOR PLAN FIRE PROTECTION	NATURE INN				X	
ROADWAY							
CR1.0	SITE LAYOUT PLAN	NATURE INN					X
CR1.1	SITE LAYOUT PLAN	NATURE INN					X
CR1.2	SITE LAYOUT PLAN	NATURE INN					X
CR2.0	BASE REPAIR AREAS AND ROADWAY CROSS SECTIONS	NATURE INN					X
CR3.0	DETAILS	NATURE INN					X
CR4.0	EROSION AND SEDIMENTATION CONTROL PLAN	NATURE INN					X

G:\Projects\2007\070915\dwg\AS BUILT\TSD\09-15-C00.dwg, 070915 TITLE SHEET, 10/5/2010 10:03:11 AM, hrampton

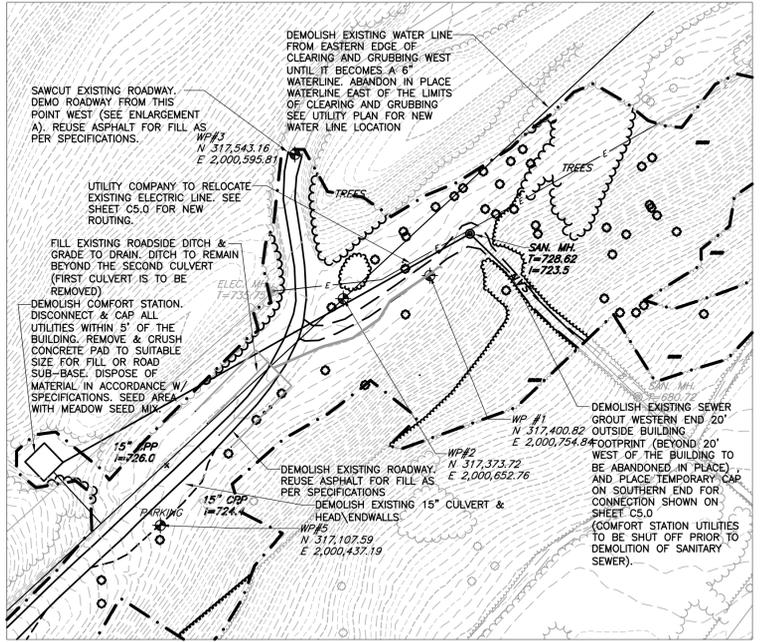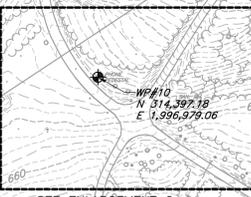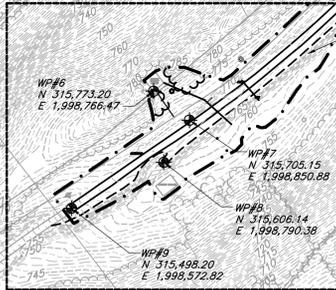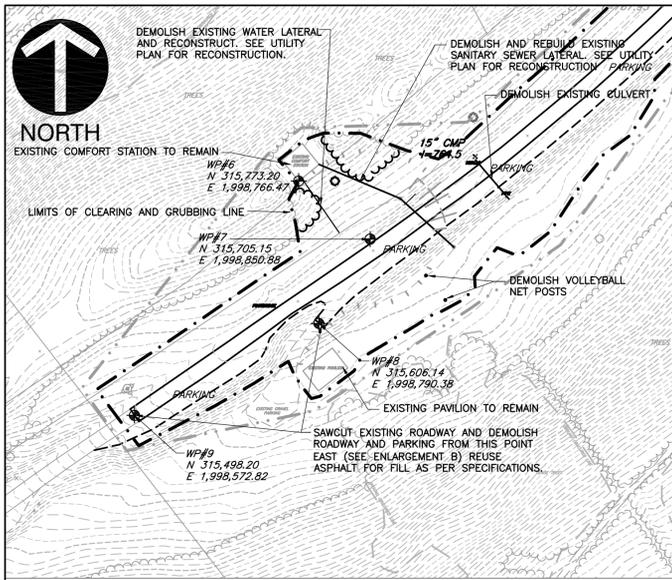

LEGEND

---	EXISTING PROPERTY BOUNDARY
---	EXISTING CONTOUR
---	EXISTING GUIDE RAIL
---	EXISTING FENCE
---	EXISTING TREE LINE
---	EXISTING SANITARY SEWER LINE
---	EXISTING STORM SEWER LINE
---	EXISTING UNDERGROUND TELEPHONE LINE
---	EXISTING UNDERGROUND ELECTRIC LINE
---	EXISTING WATER LINE
---	EXISTING WATER BOX
---	EXISTING CATCH BASIN
---	EXISTING SANITARY MANHOLE
---	EXISTING UTILITY MANHOLE
---	EXISTING FIRE HYDRANT
---	EXISTING SIGN
---	EXISTING TREE
---	WORK POINT
---	NORTHING
---	EASTING
---	PROPOSED LIMIT OF CLEARING AND GRUBBING

- NOTES**
- EXISTING CONDITIONS AS DEPICTED ON THESE PLANS ARE GENERAL AND ILLUSTRATIVE IN NATURE. IT IS THE RESPONSIBILITY OF THE CONTRACTOR TO EXAMINE THE SITE AND BE FAMILIAR WITH EXISTING CONDITIONS PRIOR TO BIDDING ON THIS PROJECT. IF CONDITIONS ENCOUNTERED DURING EXAMINATION ARE SIGNIFICANTLY DIFFERENT THAN THOSE SHOWN, THE CONTRACTOR SHALL NOTIFY THE DEPARTMENT IMMEDIATELY.
 - ALL EXISTING ABOVE AND BELOW GROUND STRUCTURES WITHIN THE LIMITS OF CONSTRUCTION SHALL BE REMOVED UNLESS NOTED OTHERWISE WITHIN THIS CONSTRUCTION SET AND/OR PROJECT SPECIFICATIONS. THIS INCLUDES FOUNDATION SLABS, WALLS AND FOOTINGS. IN ADDITION, ALL EXISTING UTILITY SERVICES TO BUILDINGS SHALL BE DISCONNECTED AND TERMINATED PER EACH UTILITY COMPANY'S REQUIREMENTS.
 - ALL WORK PERFORMED BY THE CONTRACTOR SHALL CONFORM TO THE LATEST REGULATIONS OF THE AMERICANS WITH DISABILITIES ACT. CONTRACTOR SHALL ALSO CONTACT PENNSYLVANIA ONE CALL SYSTEM, INC. AT 800-242-1776 AND THE APPROPRIATE UTILITY COMPANIES AT LEAST THREE (3) DAYS PRIOR TO THE INITIATION OF EARTH MOVING AND DEMOLITION ACTIVITIES.
 - THE CONTRACTOR SHALL INDEMNIFY AND HOLD HARMLESS THE DEPARTMENT FOR ANY AND ALL INJURIES AND/OR DAMAGES TO PERSONNEL, EQUIPMENT AND/OR EXISTING FACILITIES OCCURRING IN THE COURSE OF THE DEMOLITION AND CONSTRUCTION DESCRIBED IN THE PLANS AND SPECIFICATIONS.
 - PROJECT LIMIT LINE IS DEFINED IN THE APPROVED EROSION AND SEDIMENTATION CONTROL PLAN. SEE SHEET C9.0-C9.5

- REFERENCES**
- EXISTING TOPOGRAPHY PREPARED BY NOR EAST MAPPING, INC. JOB# NEM08006 DATE OF PHOTOGRAPHY: JAN 31, 2008 BALDEAGLE.DWG
 - EXISTING SUBSURFACE SANITARY SEWER INFORMATION INTERPRETED FROM DRAWING TITLED SANITARY SEWER REHABILITATION BALD EAGLE STATE PARK PLAN AND DETAIL FROM PROJECT NO. MM 91-6133A DATED SEP 1991
 - EXISTING SUBSURFACE WATER LINE AND ELECTRIC LINE INFORMATION INTERPRETED FROM DRAWING TITLED FOSTER JOSEPH SAVERS RESERVOIR SANITARY SYSTEMS FOR PUBLIC USE FACILITIES BALD EAGLE STATE PARK GENERAL PLAN DATED SEP 1973

ONE CALL SERIAL NO.: 0925482

CALL BEFORE YOU DIG!
PENNSYLVANIA LAW REQUIRES 3 WORKING DAYS NOTICE FOR CONSTRUCTION PHASE AND 10 WORKING DAYS IN DESIGN STAGE-STOP CALL PENNSYLVANIA ONE CALL SYSTEM, INC. 1-800-242-1776

PENNSYLVANIA ACT 38 (1991) REQUIRES NO LESS THAN 3 WORKING DAYS NOTICE NOR MORE THAN 10 WORKING DAYS NOTICE FROM EXCAVATORS WHO ARE ABOUT TO DIG, DRILL, BLAST, AUGER, BORE, GRADE, TRENCH, OR DEMOLISH IN THE CONSTRUCTION PHASE. FOR LOCATION REQUESTS IN THE STATE OF PENNSYLVANIA, CALL TOLL FREE 1-800-242-1776. UNDERGROUND UTILITIES HAVE BEEN PLOTTED FROM AVAILABLE INFORMATION AND THE LOCATION MUST BE CONSIDERED APPROXIMATE. OTHER UNDERGROUND UTILITIES MAY EXIST WHICH ARE NOT SHOWN. IT WILL BE THE CONTRACTOR'S RESPONSIBILITY TO ASCERTAIN ALL PHYSICAL LOCATIONS OF UTILITY LINES PRIOR TO THE TIME OF CONSTRUCTION. IN NO WAY SHALL THE CONTRACTOR HOLD THE SURVEYOR RESPONSIBLE FOR ANY UTILITY LOCATION SHOWN ON THIS PLAN.

C&E
Civil & Environmental Consultants, Inc.
333 Baldwin Road - Pittsburgh, PA 15205-9072
Ph: 412.429.2324 - 800.365.2324 - Fax: 412.429.2114
www.ccecinc.com

PROJECT NUMBER
070-915

NO.	DATE	REVISION	APPR.
1	09/18/08	ISSUED FOR ADDENDUM	

SUBMITTED _____

PROJECT DESIGNER _____ PROJECT COORDINATOR _____

APPROVED _____

CHIEF - CREATION OF DESIGN _____

APPROVED _____

DIRECTOR - BUREAU OF FACILITY DESIGN AND CONSTRUCTION _____

AS-BUILT
THIS RECORD DRAWING HAS BEEN PREPARED ON INFORMATION PROVIDED BY OTHERS. THE DESIGN PROFESSIONAL HAS NOT VERIFIED THE ACCURACY AND/OR COMPLETENESS OF THIS INFORMATION AND SHALL NOT BE RESPONSIBLE FOR ANY ERRORS OR OMISSIONS WHICH MAY BE INCORPORATED HEREIN AS A RESULT.

COMMONWEALTH OF PENNSYLVANIA
DEPARTMENT OF CONSERVATION AND NATURAL RESOURCES
OFFICE OF PARKS AND FORESTRY

PROJECT NO: FDC-133-4494


APPLICABLE CONTRACT NO'S.

GENERAL: FDC-133-4494.1	PLUMBING:
HVAC:	ELECTRICAL:
ROADWAY:	

THE INN AT BALD EAGLE STATE PARK
HOWARD AND LIBERTY TOWNSHIP,
CENTRE COUNTY, PENNSYLVANIA

OVERALL EXISTING CONDITIONS
/ DEMOLITION PLAN

DRAWN BY: TAF	DATE: 09/18/08	DRAWING NO.: C1.0
CHECKED BY: MWT	SCALE: AS SHOWN	

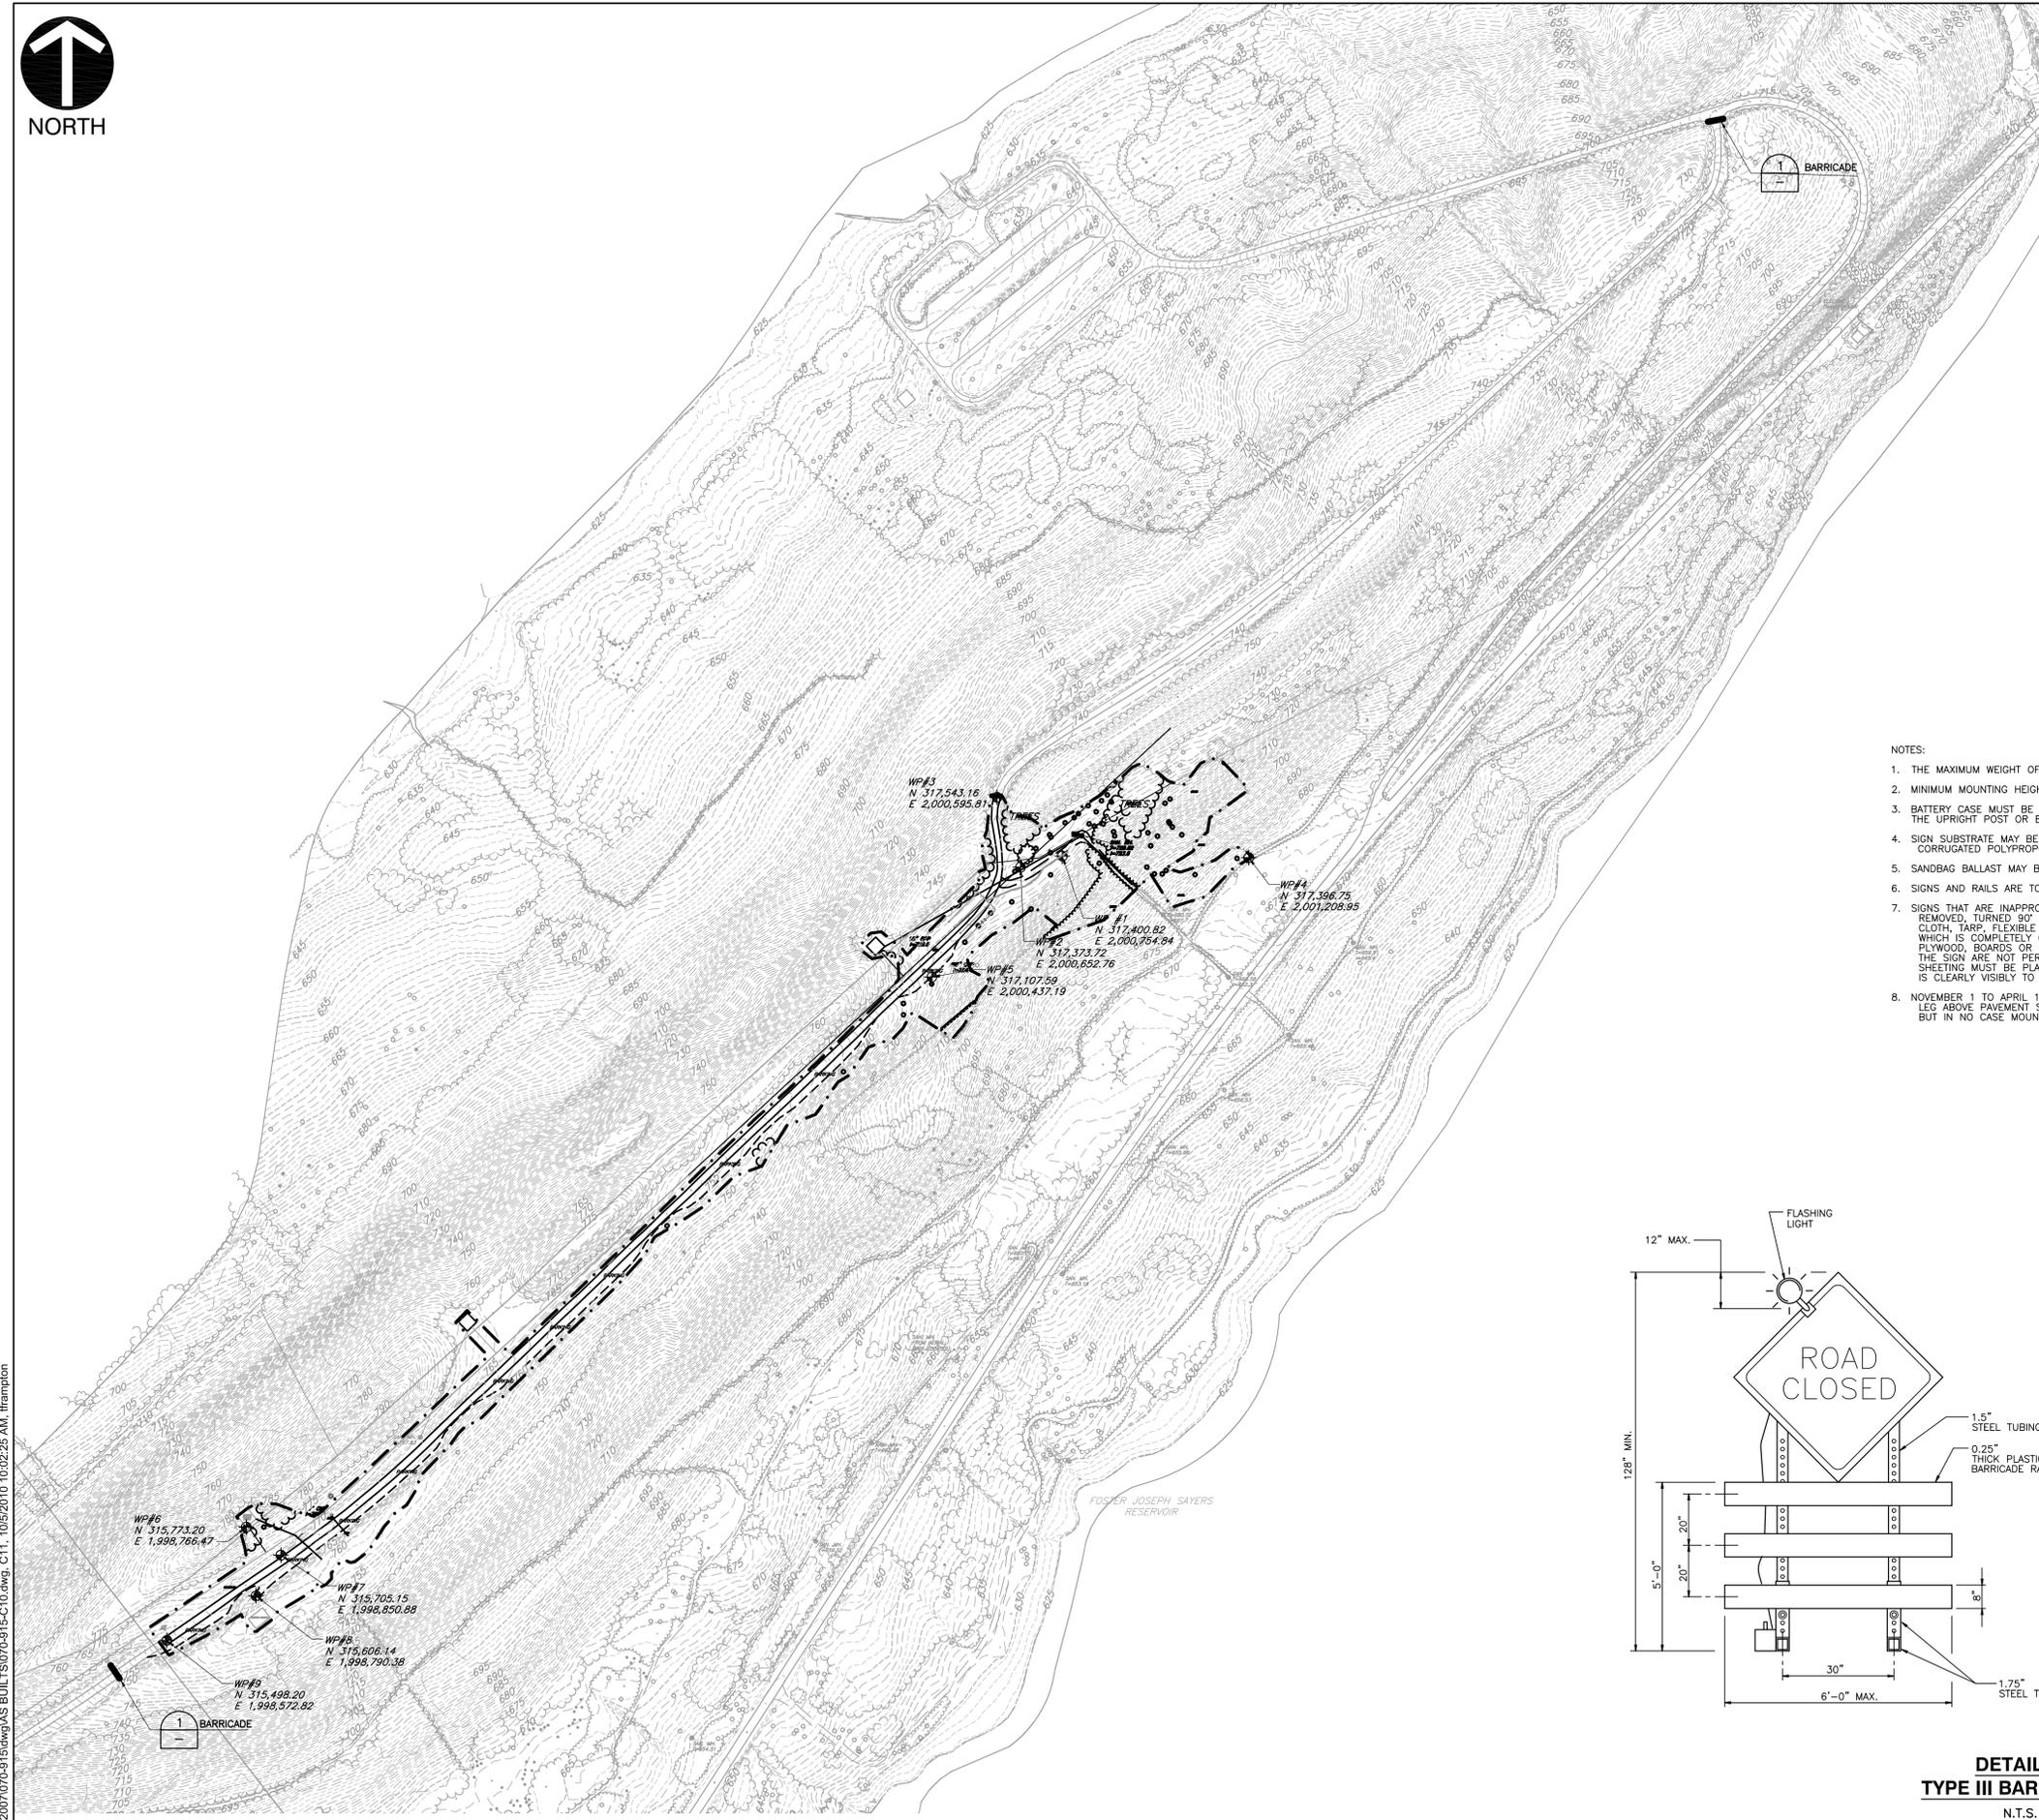

LEGEND

	EXISTING PROPERTY BOUNDARY
	EXISTING CONTOUR
	EXISTING GUIDE RAIL
	EXISTING FENCE
	EXISTING TREE LINE
	EXISTING SANITARY SEWER LINE
	EXISTING STORM SEWER LINE
	EXISTING UNDERGROUND TELEPHONE LINE
	EXISTING WATER LINE
	EXISTING WATER BOX
	EXISTING CATCH BASIN
	EXISTING SANITARY MANHOLE
	EXISTING UTILITY MANHOLE
	EXISTING FIRE HYDRANT
	EXISTING SIGN
	EXISTING TREE
	WORK POINT
	NORTHING
	FASTENING
	PROPOSED LIMIT OF CLEARING AND GRUBBING

- NOTES**
- EXISTING CONDITIONS AS DEPICTED ON THESE PLANS ARE GENERAL AND ILLUSTRATIVE IN NATURE. IT IS THE RESPONSIBILITY OF THE CONTRACTOR TO EXAMINE THE SITE AND BE FAMILIAR WITH EXISTING CONDITIONS PRIOR TO BIDDING ON THIS PROJECT. IF CONDITIONS ENCOUNTERED DURING EXAMINATION ARE SIGNIFICANTLY DIFFERENT THAN THOSE SHOWN, THE CONTRACTOR SHALL NOTIFY THE DEPARTMENT IMMEDIATELY.
 - ALL EXISTING ABOVE AND BELOW GROUND STRUCTURES WITHIN THE LIMITS OF CONSTRUCTION SHALL BE REMOVED UNLESS NOTED OTHERWISE WITHIN THIS CONSTRUCTION SET AND/OR PROJECT SPECIFICATIONS. THIS INCLUDES FOUNDATION SLABS, WALLS AND FOOTINGS. IN ADDITION, ALL EXISTING UTILITY SERVICES TO BUILDINGS SHALL BE DISCONNECTED AND TERMINATED PER EACH UTILITY COMPANY'S REQUIREMENTS.
 - ALL WORK PERFORMED BY THE CONTRACTOR SHALL CONFORM TO THE LATEST REGULATIONS OF THE AMERICANS WITH DISABILITIES ACT. CONTRACTOR SHALL ALSO CONTACT PENNSYLVANIA ONE CALL SYSTEM, INC. AT 800-242-1776 AND THE APPROPRIATE UTILITY COMPANIES AT LEAST THREE (3) DAYS PRIOR TO THE INITIATION OF EARTH MOVING AND DEMOLITION ACTIVITIES.
 - THE CONTRACTOR SHALL INDEMNIFY AND HOLD HARMLESS THE DEPARTMENT FOR ANY AND ALL INJURIES AND/OR DAMAGES TO PERSONNEL, EQUIPMENT AND/OR EXISTING FACILITIES OCCURRING IN THE COURSE OF THE DEMOLITION AND CONSTRUCTION DESCRIBED IN THE PLANS AND SPECIFICATIONS.
 - PROJECT LIMIT LINE IS DEFINED IN THE APPROVED EROSION AND SEDIMENTATION CONTROL PLAN. SEE SHEET C9.0-C9.5

- REFERENCES**
- EXISTING TOPOGRAPHY PREPARED BY NOR EAST MAPPING, INC. JOB# NEM08006 DATE OF PHOTOGRAPHY: JAN 31, 2008 BALDEAGLE.DWG
 - EXISTING SUBSURFACE SANITARY SEWER INFORMATION INTERPRETED FROM DRAWING TITLED SANITARY SEWER REHABILITATION BALD EAGLE STATE PARK PLAN AND DETAIL FROM PROJECT NO. MM 91-6133A DATED SEP 1991
 - EXISTING SUBSURFACE WATER LINE AND ELECTRIC LINE INFORMATION INTERPRETED FROM DRAWING TITLED FOSTER JOSEPH SAYERS RESERVOIR SANITARY SYSTEMS FOR PUBLIC USE FACILITIES BALD EAGLE STATE PARK GENERAL PLAN DATED SEP 1973

ONE CALL SERIAL NO.: 0925482

CALL BEFORE YOU DIG!
PENNSYLVANIA LAW REQUIRES 3 WORKING DAYS NOTICE FOR CONSTRUCTION PHASE AND 10 WORKING DAYS IN DESIGN STAGE-STOP CALL PENNSYLVANIA ONE CALL SYSTEM, INC. 1-800-242-1776

- NOTES:**
- THE MAXIMUM WEIGHT OF THE SIGN MAY NOT EXCEED 25 LB.
 - MINIMUM MOUNTING HEIGHT TO TOP OF ALL SIGNS IS 128".
 - BATTERY CASE MUST BE PLACED AT GROUND LEVEL AND FASTENED TO THE UPRIGHT POST OR BASE LEG.
 - SIGN SUBSTRATE MAY BE ALUMINUM, ALUMINUM / PLASTIC LAMINATE, CORRUGATED POLYPROPYLENE OR POLYETHYLENE.
 - SANDBAG BALLAST MAY BE PLACED ON THE BASE.
 - SIGNS AND RAILS ARE TO BE ATTACHED WITH BOLTS AND NUTS.
 - SIGNS THAT ARE INAPPROPRIATE OR NOT APPLICABLE SHOULD BE REMOVED, TURNED 90° OR COVERED. COVER MATERIAL MAY BE CLOTH, TARP, FLEXIBLE PLASTIC, OR SIMILAR MATERIAL WHICH IS COMPLETELY OPAQUE SO THE SIGN CANNOT BE READ. PLYWOOD, BOARDS OR OTHER RIGID COVERS HUNG OR ATTACHED TO THE SIGN ARE NOT PERMITTED. IF TURNED 90°, RETROREFLECTIVE SHEETING MUST BE PLACED ON THE SIDES SO THAT THE BARRICADE IS CLEARLY VISIBLY TO APPROACHING DRIVERS.
 - NOVEMBER 1 TO APRIL 1, BATTERY CASE MAY BE ATTACHED TO VERTICAL LEG ABOVE PAVEMENT SURFACE PREFERABLY BEHIND LOWER MOST RAIL, BUT IN NO CASE MOUNTED ABOVE TYPICAL PASSENGER CAR BUMPER HEIGHT.

C&E
Civil & Environmental Consultants, Inc.
333 Baldwin Road - Pittsburgh, PA 15205-9072
Ph: 412.429.2324 - 800.365.2324 - Fax: 412.429.2114
www.cecinc.com

PROJECT NUMBER 070-915

NO.	DATE	REVISION	APPR.
1	09/08/08	ISSUED FOR ADDENDUM	

SUBMITTED _____
PROJECT DESIGNER _____ PROJECT COORDINATOR _____
APPROVED _____
CHIEF - DIVISION OF DESIGN _____
APPROVED _____
DIRECTOR - BUREAU OF FACILITY DESIGN AND CONSTRUCTION _____

AS-BUILT
THIS RECORD DRAWING HAS BEEN PREPARED ON INFORMATION PROVIDED BY OTHERS. THE DESIGN PROFESSIONAL HAS NOT VERIFIED THE ACCURACY AND/OR COMPLETENESS OF THIS INFORMATION AND SHALL NOT BE RESPONSIBLE FOR ANY ERRORS OR OMISSIONS WHICH MAY BE INCORPORATED HEREIN AS A RESULT.

COMMONWEALTH OF PENNSYLVANIA
DEPARTMENT OF CONSERVATION AND NATURAL RESOURCES
OFFICE OF PARKS AND FORESTRY

PROJECT NO: FDC-133-4494


APPLICABLE CONTRACT NO'S.

GENERAL: FDC-133-4494.1	PLUMBING:
HVAC:	ELECTRICAL:
ROADWAY:	


THE INN AT BALD EAGLE STATE PARK
HOWARD AND LIBERTY TOWNSHIP,
CENTRE COUNTY, PENNSYLVANIA

SIGNAGE PLAN

DRAWN BY: TAF	DATE: 09/18/08	DRAWING NO: C1.1
CHECKED BY: MWT	SCALE: AS SHOWN	

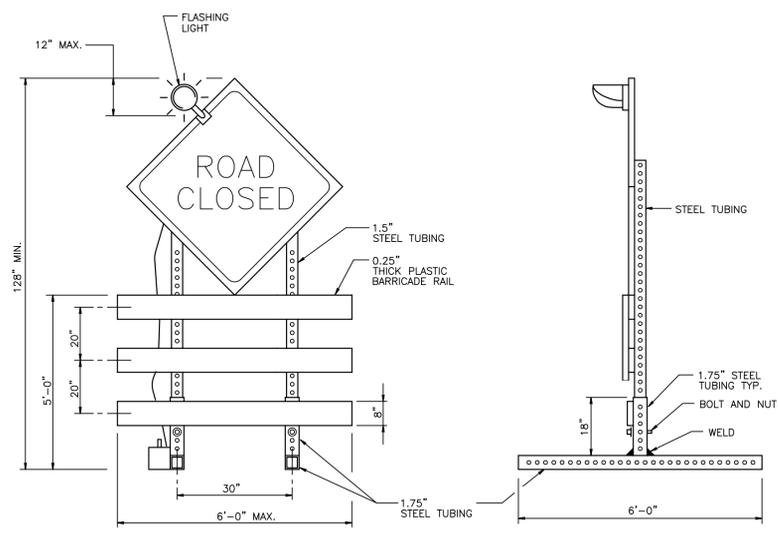


DETAIL 1
TYPE III BARRICADE
N.T.S.

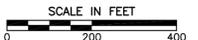

G:\Projects\2007\070-915\dwg\AS-BUILT\070-915-C1.1.dwg, C1.1, 10/20/10 10:02:25 AM, kframpton

* SIGNATURE ON FILE

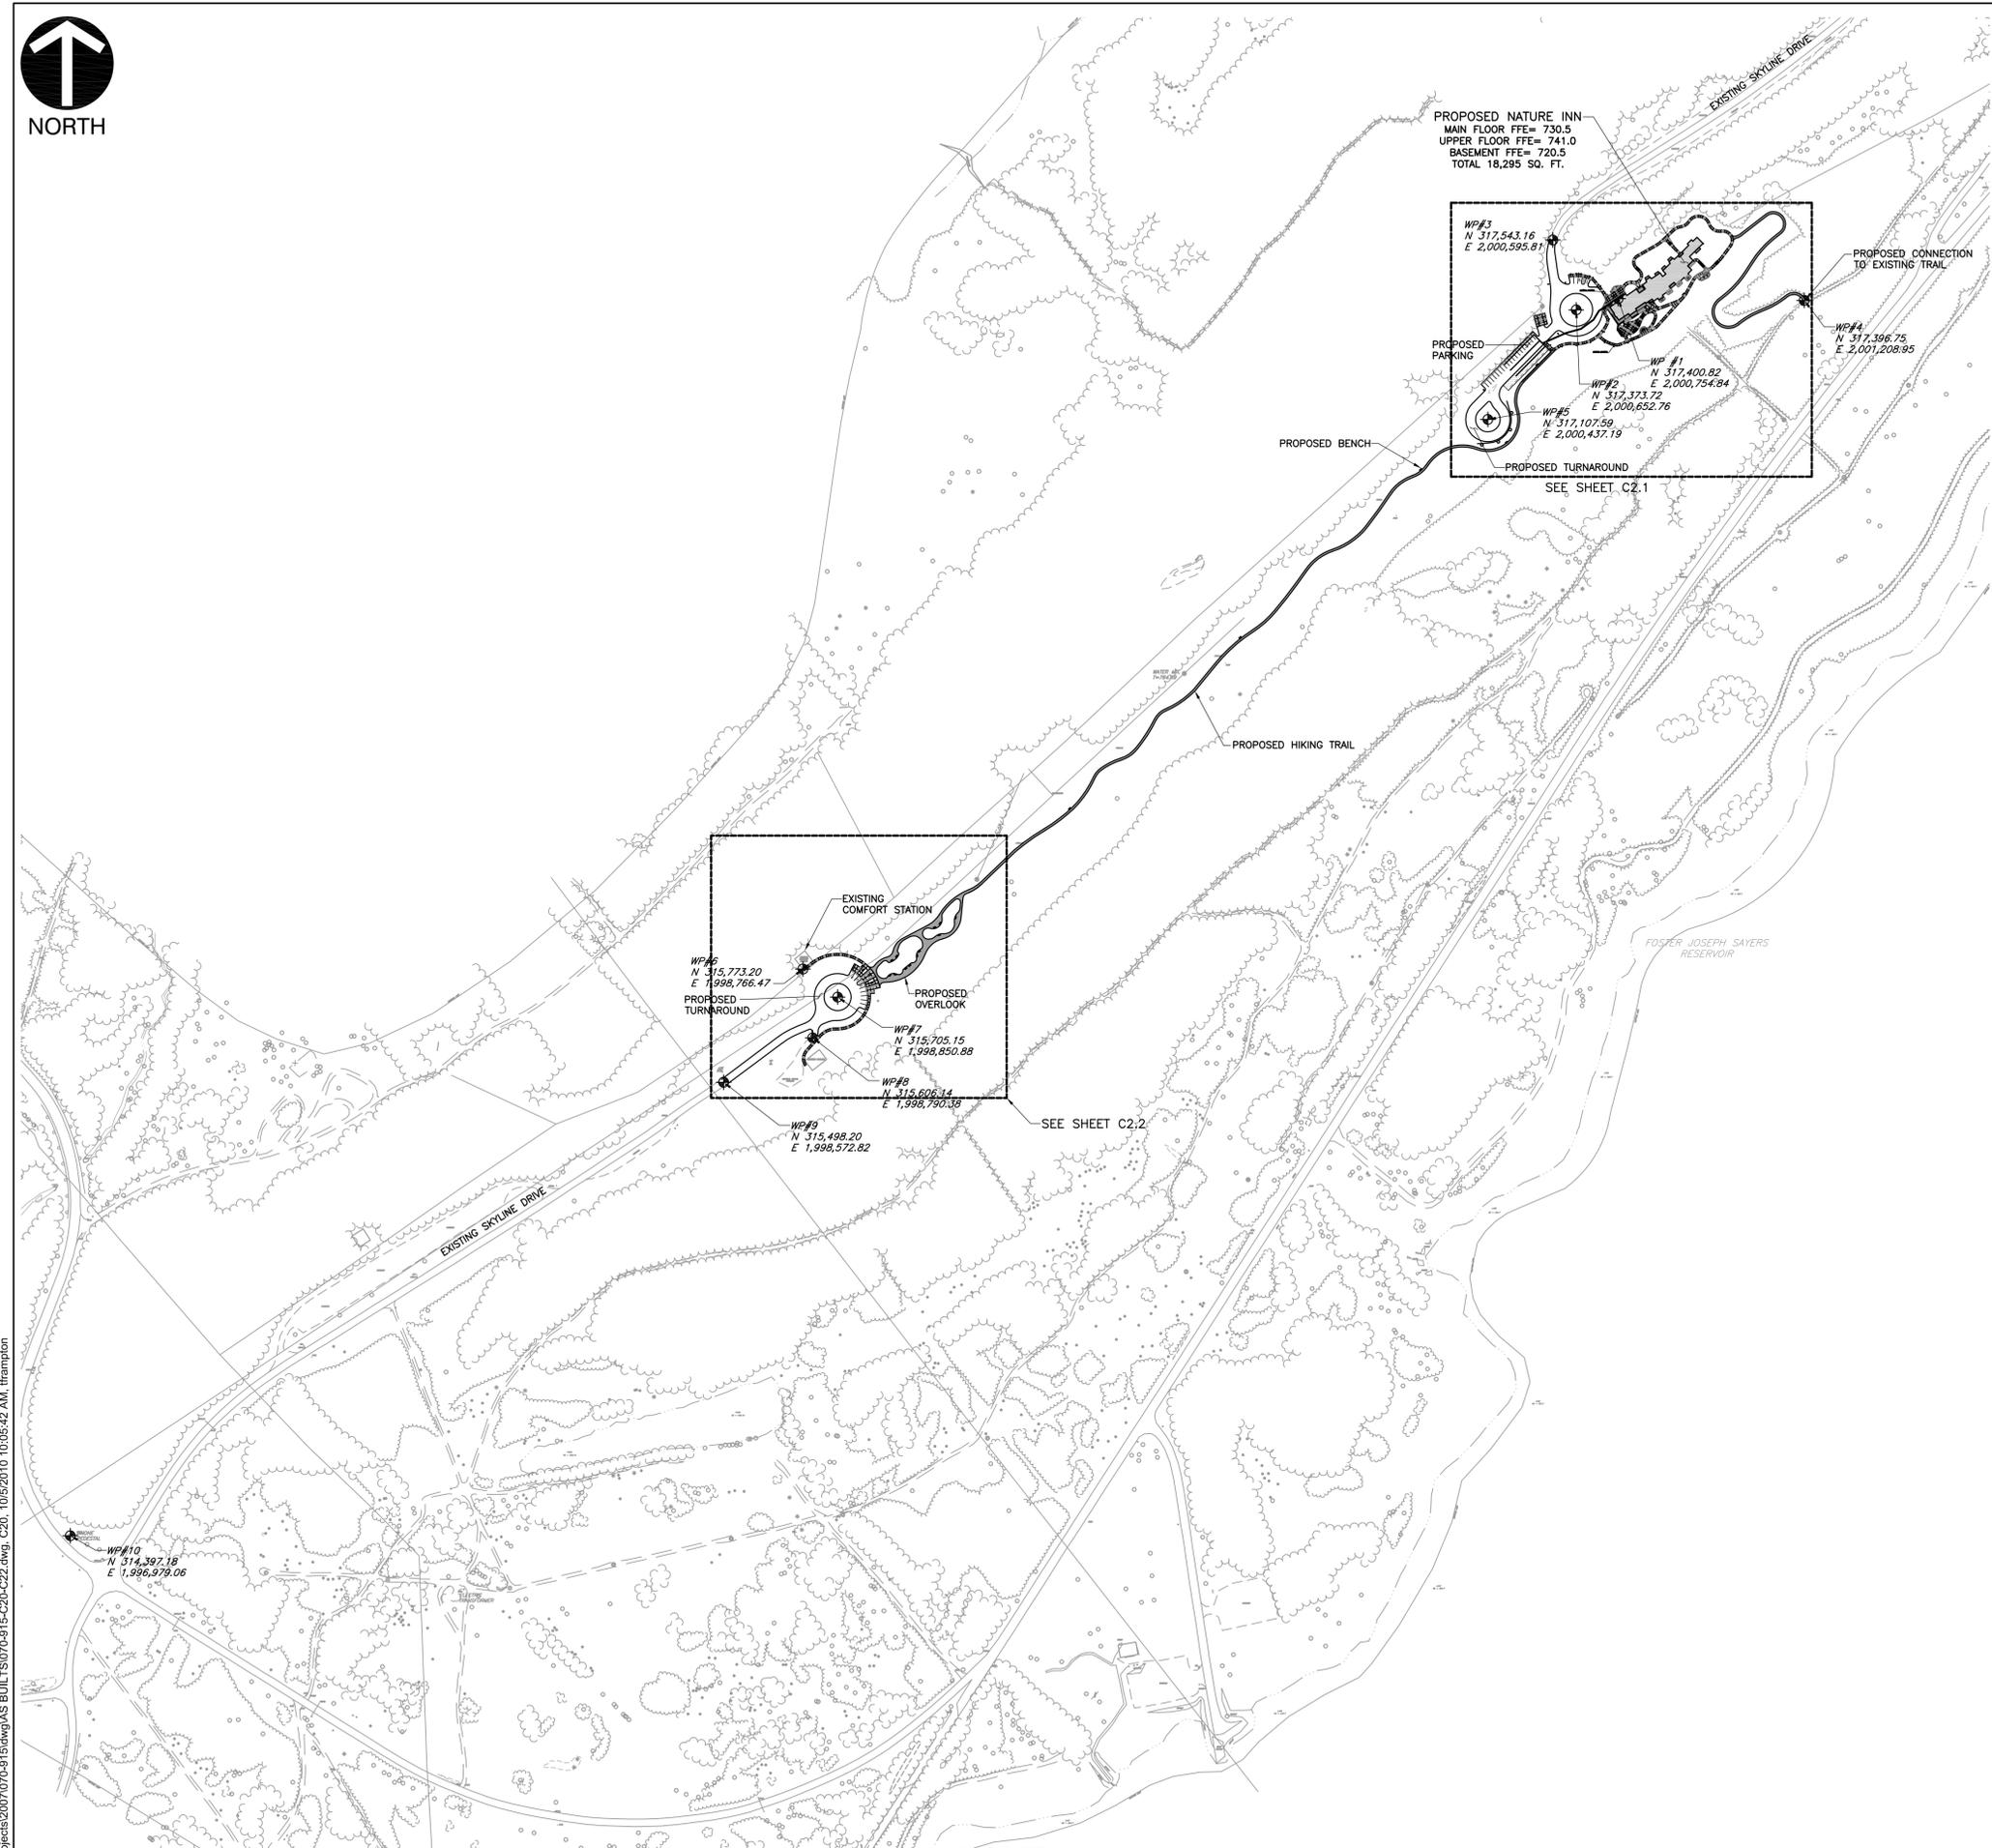

LEGEND

	EXISTING PROPERTY BOUNDARY
	EXISTING CONTOUR
	EXISTING GUIDE RAIL
	EXISTING FENCE
	EXISTING TREE LINE
	EXISTING SANITARY SEWER LINE
	EXISTING STORM SEWER LINE
	EXISTING UNDERGROUND TELEPHONE LINE
	EXISTING WATER LINE
	EXISTING WATER BOX
	EXISTING CATCH BASIN
	EXISTING SANITARY MANHOLE
	EXISTING UTILITY MANHOLE
	EXISTING FIRE HYDRANT
	EXISTING SIGN
	EXISTING TREE
	WORK POINT
	NORTHING
	EASTING
	PROPOSED BUILDING
	PROPOSED CONCRETE PAD
	PROPOSED CONCRETE WALKWAY
	PROPOSED REINFORCED TURF PARKING
	PROPOSED HIKING TRAIL
	PROPOSED BRIDGE
	PROPOSED GUIDE RAIL
	PROPOSED CENTERLINE
	PROPOSED ADA PARKING
	PROPOSED SIGN
	PROPOSED WHEEL STOP
	PROPOSED PARKING COUNT
	DETAIL NUMBER
	SHEET NUMBER

- NOTES**
- EXISTING CONDITIONS AS DEPICTED ON THESE PLANS ARE GENERAL AND ILLUSTRATIVE IN NATURE. IT IS THE RESPONSIBILITY OF THE CONTRACTOR TO EXAMINE THE SITE AND BE FAMILIAR WITH EXISTING CONDITIONS PRIOR TO BIDDING ON THIS PROJECT. IF CONDITIONS ENCOUNTERED DURING EXAMINATION ARE SIGNIFICANTLY DIFFERENT THAN THOSE SHOWN, THE CONTRACTOR SHALL NOTIFY THE DEPARTMENT IMMEDIATELY.
 - ALL EXISTING ABOVE AND BELOW GROUND STRUCTURES WITHIN THE LIMITS OF CONSTRUCTION SHALL BE REMOVED UNLESS NOTED OTHERWISE WITHIN THIS CONSTRUCTION SET AND/OR PROJECT SPECIFICATIONS. THIS INCLUDES FOUNDATION SLABS, WALLS AND FOOTINGS. IN ADDITION, ALL EXISTING UTILITY SERVICES TO BUILDINGS SHALL BE DISCONNECTED AND TERMINATED PER EACH UTILITY COMPANY'S REQUIREMENTS.
 - ALL WORK PERFORMED BY THE CONTRACTOR SHALL CONFORM TO THE LATEST REGULATIONS OF THE AMERICANS WITH DISABILITIES ACT. CONTRACTOR SHALL ALSO CONTACT PENNSYLVANIA ONE CALL SYSTEM, INC. AT 800-242-1776 AND THE APPROPRIATE UTILITY COMPANIES AT LEAST THREE (3) DAYS PRIOR TO THE INITIATION OF EARTH MOVING AND DEMOLITION ACTIVITIES.
 - THE CONTRACTOR SHALL INDEMNIFY AND HOLD HARMLESS THE DEPARTMENT FOR ANY AND ALL INJURIES AND/OR DAMAGES TO PERSONNEL, EQUIPMENT AND/OR EXISTING FACILITIES OCCURRING IN THE COURSE OF THE DEMOLITION AND CONSTRUCTION DESCRIBED IN THE PLANS AND SPECIFICATIONS.
 - PROJECT LIMIT LINE IS DEFINED IN THE APPROVED EROSION AND SEDIMENTATION CONTROL PLAN. SEE SHEET C9.0-C9.5

- REFERENCES**
- EXISTING TOPOGRAPHY PREPARED BY NOR EAST MAPPING, INC. JOB# NEM08006 DATE OF PHOTOGRAPHY: JAN 31, 2008 BALDEAGLE.DWG
 - EXISTING SUBSURFACE SANITARY SEWER INFORMATION INTERPRETED FROM DRAWING TITLED 'SANITARY SEWER REHABILITATION BALD EAGLE STATE PARK PLAN AND DETAIL FROM PROJECT NO. MM 91-6133A DATED SEP 1991
 - EXISTING SUBSURFACE WATER LINE AND ELECTRIC LINE INFORMATION INTERPRETED FROM DRAWING TITLED 'FOSTER JOSEPH SAYERS RESERVOIR SANITARY SYSTEMS FOR PUBLIC USE FACILITIES BALD EAGLE STATE PARK GENERAL PLAN DATED SEP 1973

ONE CALL SERIAL NO.: 0925482

CALL BEFORE YOU DIG!
PENNSYLVANIA LAW REQUIRES 3 WORKING DAYS NOTICE FOR CONSTRUCTION PHASE AND 10 WORKING DAYS IN DESIGN STAGE—STOP CALL PENNSYLVANIA ONE CALL SYSTEM, INC. 1-800-242-1776

PENNSYLVANIA ACT 38 (1991) REQUIRES NO LESS THAN 3 WORKING DAYS NOTICE NOR MORE THAN 10 WORKING DAYS NOTICE FROM EXCAVATORS WHO ARE ABOUT TO DIG, DRILL, BLAST, AUGER, BORE, GRADE, TRENCH, OR DEMOLISH WHEN IN THE CONSTRUCTION PHASE. FOR LOCATION REQUESTS IN THE STATE OF PENNSYLVANIA, CALL TOLL FREE 1-800-242-1776. UNDERGROUND UTILITIES HAVE BEEN PLOTTED FROM AVAILABLE INFORMATION AND THE LOCATION MUST BE CONSIDERED APPROXIMATE. OTHER UNDERGROUND UTILITIES MAY EXIST WHICH ARE NOT SHOWN. IT WILL BE THE CONTRACTOR'S RESPONSIBILITY TO ASCERTAIN ALL PHYSICAL LOCATIONS OF UTILITY LINES PRIOR TO THE TIME OF CONSTRUCTION. IN NO WAY SHALL THE CONTRACTOR HOLD THE SURVEYOR RESPONSIBLE FOR ANY UTILITY LOCATION SHOWN ON THIS PLAN.

CEC
Civil & Environmental Consultants, Inc.
333 Baldwin Road - Pittsburgh, PA 15205-9072
Ph: 412.429.2324 • 800.365.2324 • Fax: 412.429.2114
www.cecinc.com

PROJECT NUMBER
070-915

NO.	DATE	REVISION	APPR.
1	09/08/08	ISSUED FOR ADDENDUM	

SUBMITTED _____

PROJECT DESIGNER _____ PROJECT COORDINATOR _____

APPROVED _____

CHIEF - DIVISION OF DESIGN _____

APPROVED _____

DIRECTOR - BUREAU OF FACILITY DESIGN AND CONSTRUCTION _____

AS-BUILT
THIS RECORD DRAWING HAS BEEN PREPARED ON INFORMATION PROVIDED BY OTHERS. THE DESIGN PROFESSIONAL HAS NOT VERIFIED THE ACCURACY AND/OR COMPLETENESS OF THIS INFORMATION AND SHALL NOT BE RESPONSIBLE FOR ANY ERRORS OR OMISSIONS WHICH MAY BE INCORPORATED HEREIN AS A RESULT.

COMMONWEALTH OF PENNSYLVANIA
DEPARTMENT OF CONSERVATION AND NATURAL RESOURCES
OFFICE OF PARKS AND FORESTRY

PROJECT NO: FDC-133-4494

APPLICABLE CONTRACT NO'S.

GENERAL: FDC-133-4494.1	PLUMBING:
HVAC:	ELECTRICAL:
ROADWAY:	

**THE INN AT BALD EAGLE STATE PARK
HOWARD AND LIBERTY TOWNSHIP,
CENTRE COUNTY, PENNSYLVANIA**

OVERALL LAYOUT PLAN

DRAWN BY: TAF	DATE: 09/18/08	DRAWING NO: C2.0
CHECKED BY: MWT	SCALE: 1"=200'	

* SIGNATURE OR FILE

G:\Projects\2007\070-915\dwg\AS-BUILT\070-915-C20-C22.dwg, C20, 10/29/2010 10:05:42 AM, hrampton





LEGEND	
	EXISTING PROPERTY BOUNDARY
	EXISTING CONTOUR
	EXISTING GUIDE RAIL
	EXISTING FENCE
	EXISTING TREE LINE
	EXISTING SANITARY SEWER LINE
	EXISTING STORM SEWER LINE
	EXISTING UNDERGROUND TELEPHONE LINE
	EXISTING WATER LINE
	EXISTING WATER BOX
	EXISTING CATCH BASIN
	EXISTING SANITARY MANHOLE
	EXISTING UTILITY MANHOLE
	EXISTING FIRE HYDRANT
	EXISTING SIGN
	EXISTING TREE
	WORK POINT
	NORTHING
	EASTING
	PROPOSED BUILDING
	PROPOSED CONCRETE PAD
	PROPOSED CONCRETE WALKWAY
	PROPOSED REINFORCED TURF PARKING
	PROPOSED HIKING TRAIL
	PROPOSED BRIDGE
	PROPOSED GUIDE RAIL
	PROPOSED CENTERLINE
	PROPOSED ADA PARKING
	PROPOSED SIGN
	PROPOSED WHEEL STOP
	PROPOSED PARKING COUNT
	DETAIL NUMBER
	SHEET NUMBER

- ### NOTES
- EXISTING CONDITIONS AS DEPICTED ON THESE PLANS ARE GENERAL AND ILLUSTRATIVE IN NATURE. IT IS THE RESPONSIBILITY OF THE CONTRACTOR TO EXAMINE THE SITE AND BE FAMILIAR WITH EXISTING CONDITIONS PRIOR TO BIDDING ON THIS PROJECT. IF CONDITIONS ENCOUNTERED DURING EXAMINATION ARE SIGNIFICANTLY DIFFERENT THAN THOSE SHOWN, THE CONTRACTOR SHALL NOTIFY THE DEPARTMENT IMMEDIATELY.
 - ALL EXISTING ABOVE AND BELOW GROUND STRUCTURES WITHIN THE LIMITS OF CONSTRUCTION SHALL BE REMOVED UNLESS NOTED OTHERWISE WITHIN THIS CONSTRUCTION SET AND/OR PROJECT SPECIFICATIONS. THIS INCLUDES FOUNDATION SLABS, WALLS AND FOOTINGS. IN ADDITION, ALL EXISTING UTILITY SERVICES TO BUILDINGS SHALL BE DISCONNECTED AND TERMINATED PER EACH UTILITY COMPANY'S REQUIREMENTS.
 - ALL WORK PERFORMED BY THE CONTRACTOR SHALL CONFORM TO THE LATEST REGULATIONS OF THE AMERICANS WITH DISABILITIES ACT. CONTRACTOR SHALL ALSO CONTACT PENNSYLVANIA ONE CALL SYSTEM, INC. AT 800-242-1776 AND THE APPROPRIATE UTILITY COMPANIES AT LEAST THREE (3) DAYS PRIOR TO THE INITIATION OF EARTH MOVING AND DEMOLITION ACTIVITIES.
 - THE CONTRACTOR SHALL INDEMNIFY AND HOLD HARMLESS THE DEPARTMENT FOR ANY AND ALL INJURIES AND/OR DAMAGES TO PERSONNEL, EQUIPMENT AND/OR EXISTING FACILITIES OCCURRING IN THE COURSE OF THE DEMOLITION AND CONSTRUCTION DESCRIBED IN THE PLANS AND SPECIFICATIONS.
 - PROJECT LIMIT LINE IS DEFINED IN THE APPROVED EROSION AND SEDIMENTATION CONTROL PLAN. SEE SHEET C9.0-C9.5

- ### REFERENCES
- EXISTING TOPOGRAPHY PREPARED BY NOR EAST MAPPING, INC. JOB# NEM08006 DATE OF PHOTOGRAPHY: JAN 31, 2008 BALDEAGLE.DWG
 - EXISTING SUBSURFACE SANITARY SEWER INFORMATION INTERPRETED FROM DRAWING TITLED "SANITARY SEWER REHABILITATION BALD EAGLE STATE PARK PLAN AND DETAIL FROM PROJECT NO. MM 91-6133A DATED SEP 1991"
 - EXISTING SUBSURFACE WATER LINE AND ELECTRIC LINE INFORMATION INTERPRETED FROM DRAWING TITLED "FOSTER JOSEPH SAVERS RESERVOIR SANITARY SYSTEMS FOR PUBLIC USE FACILITIES BALD EAGLE STATE PARK GENERAL PLAN DATED SEP 1973"

ONE CALL SERIAL NO.: 0925482

CALL BEFORE YOU DIG!
PENNSYLVANIA LAW REQUIRES 3 WORKING DAYS NOTICE FOR CONSTRUCTION PHASE AND 10 WORKING DAYS IN DESIGN STAGE-STOP CALL PENNSYLVANIA ONE CALL SYSTEM, INC. 1-800-242-1776

PENNSYLVANIA ACT 38 (1991) REQUIRES NO LESS THAN 3 WORKING DAYS NOTICE NOR MORE THAN 10 WORKING DAYS NOTICE FROM EXCAVATORS WHO ARE ABOUT TO DIG, DRILL, BLAST, AUGER, BORE, GRADE, BENCH, OR DEMOLISH WHEN IN THE CONSTRUCTION PHASE. FOR LOCATION REQUESTS IN THE STATE OF PENNSYLVANIA, CALL TOLL FREE 1-800-242-1776. UNDERGROUND UTILITIES HAVE BEEN PLOTTED FROM AVAILABLE INFORMATION AND THE LOCATION MUST BE CONSIDERED APPROXIMATE. OTHER UNDERGROUND UTILITIES MAY EXIST WHICH ARE NOT SHOWN. IT WILL BE THE CONTRACTOR'S RESPONSIBILITY TO ASCERTAIN ALL PHYSICAL LOCATIONS OF UTILITY LINES PRIOR TO THE TIME OF CONSTRUCTION. IN NO WAY SHALL THE CONTRACTOR HOLD THE SURVEYOR RESPONSIBLE FOR ANY UTILITY LOCATION SHOWN ON THIS PLAN.

		Civil & Environmental Consultants, Inc.		PROJECT NUMBER 070-915	
333 Baldwin Road - Pittsburgh, PA 15205-9072		Ph: 412.429.2324 • 800.365.2324 • Fax: 412.429.2114		www.cecinc.com	
NO.	DATE	REVISION	APPR.		
1	09/08/08	ISSUED FOR ADDENDUM			
SUBMITTED					
PROJECT DESIGNER			PROJECT COORDINATOR		
APPROVED					
CHIEF - DIVISION OF DESIGN					
APPROVED					
DIRECTOR - BUREAU OF FACILITY DESIGN AND CONSTRUCTION					

AS-BUILT
THIS RECORD DRAWING HAS BEEN PREPARED ON INFORMATION PROVIDED BY OTHERS. THE DESIGN PROFESSIONAL HAS NOT VERIFIED THE ACCURACY AND/OR COMPLETENESS OF THIS INFORMATION AND SHALL NOT BE RESPONSIBLE FOR ANY ERRORS OR OMISSIONS WHICH MAY BE INCORPORATED HEREIN AS A RESULT.

COMMONWEALTH OF PENNSYLVANIA
DEPARTMENT OF CONSERVATION AND NATURAL RESOURCES
OFFICE OF PARKS AND FORESTRY

PROJECT NO: FDC-133-4494

APPLICABLE CONTRACT NO'S.

GENERAL:	FDC-133-4494.1	PLUMBING:	
HVAC:		ELECTRICAL:	
ROADWAY:			

**THE INN AT BALD EAGLE STATE PARK
HOWARD AND LIBERTY TOWNSHIP,
CENTRE COUNTY, PENNSYLVANIA**




ENLARGED LAYOUT PLAN

DRAWN BY:	TAF	DATE:	09/18/08	DRAWING NO.:	C2.2
CHECKED BY:	MWT	SCALE:	1"=30'		



G:\Projects\2007\070-915\dwg\AS-BUILT\070-915-C20-C22.dwg, C22, 10/19/2010 10:05:15 AM, htramplon

*** SIGNATURE ON FILE ***

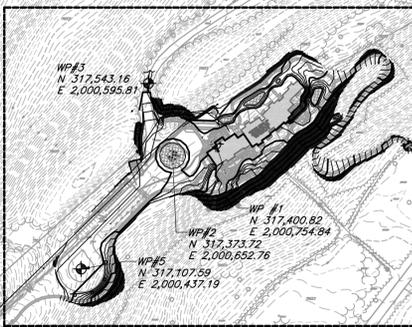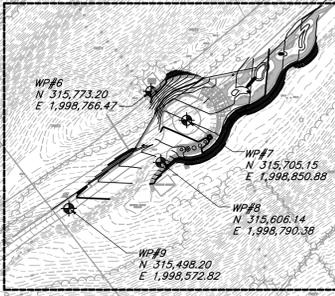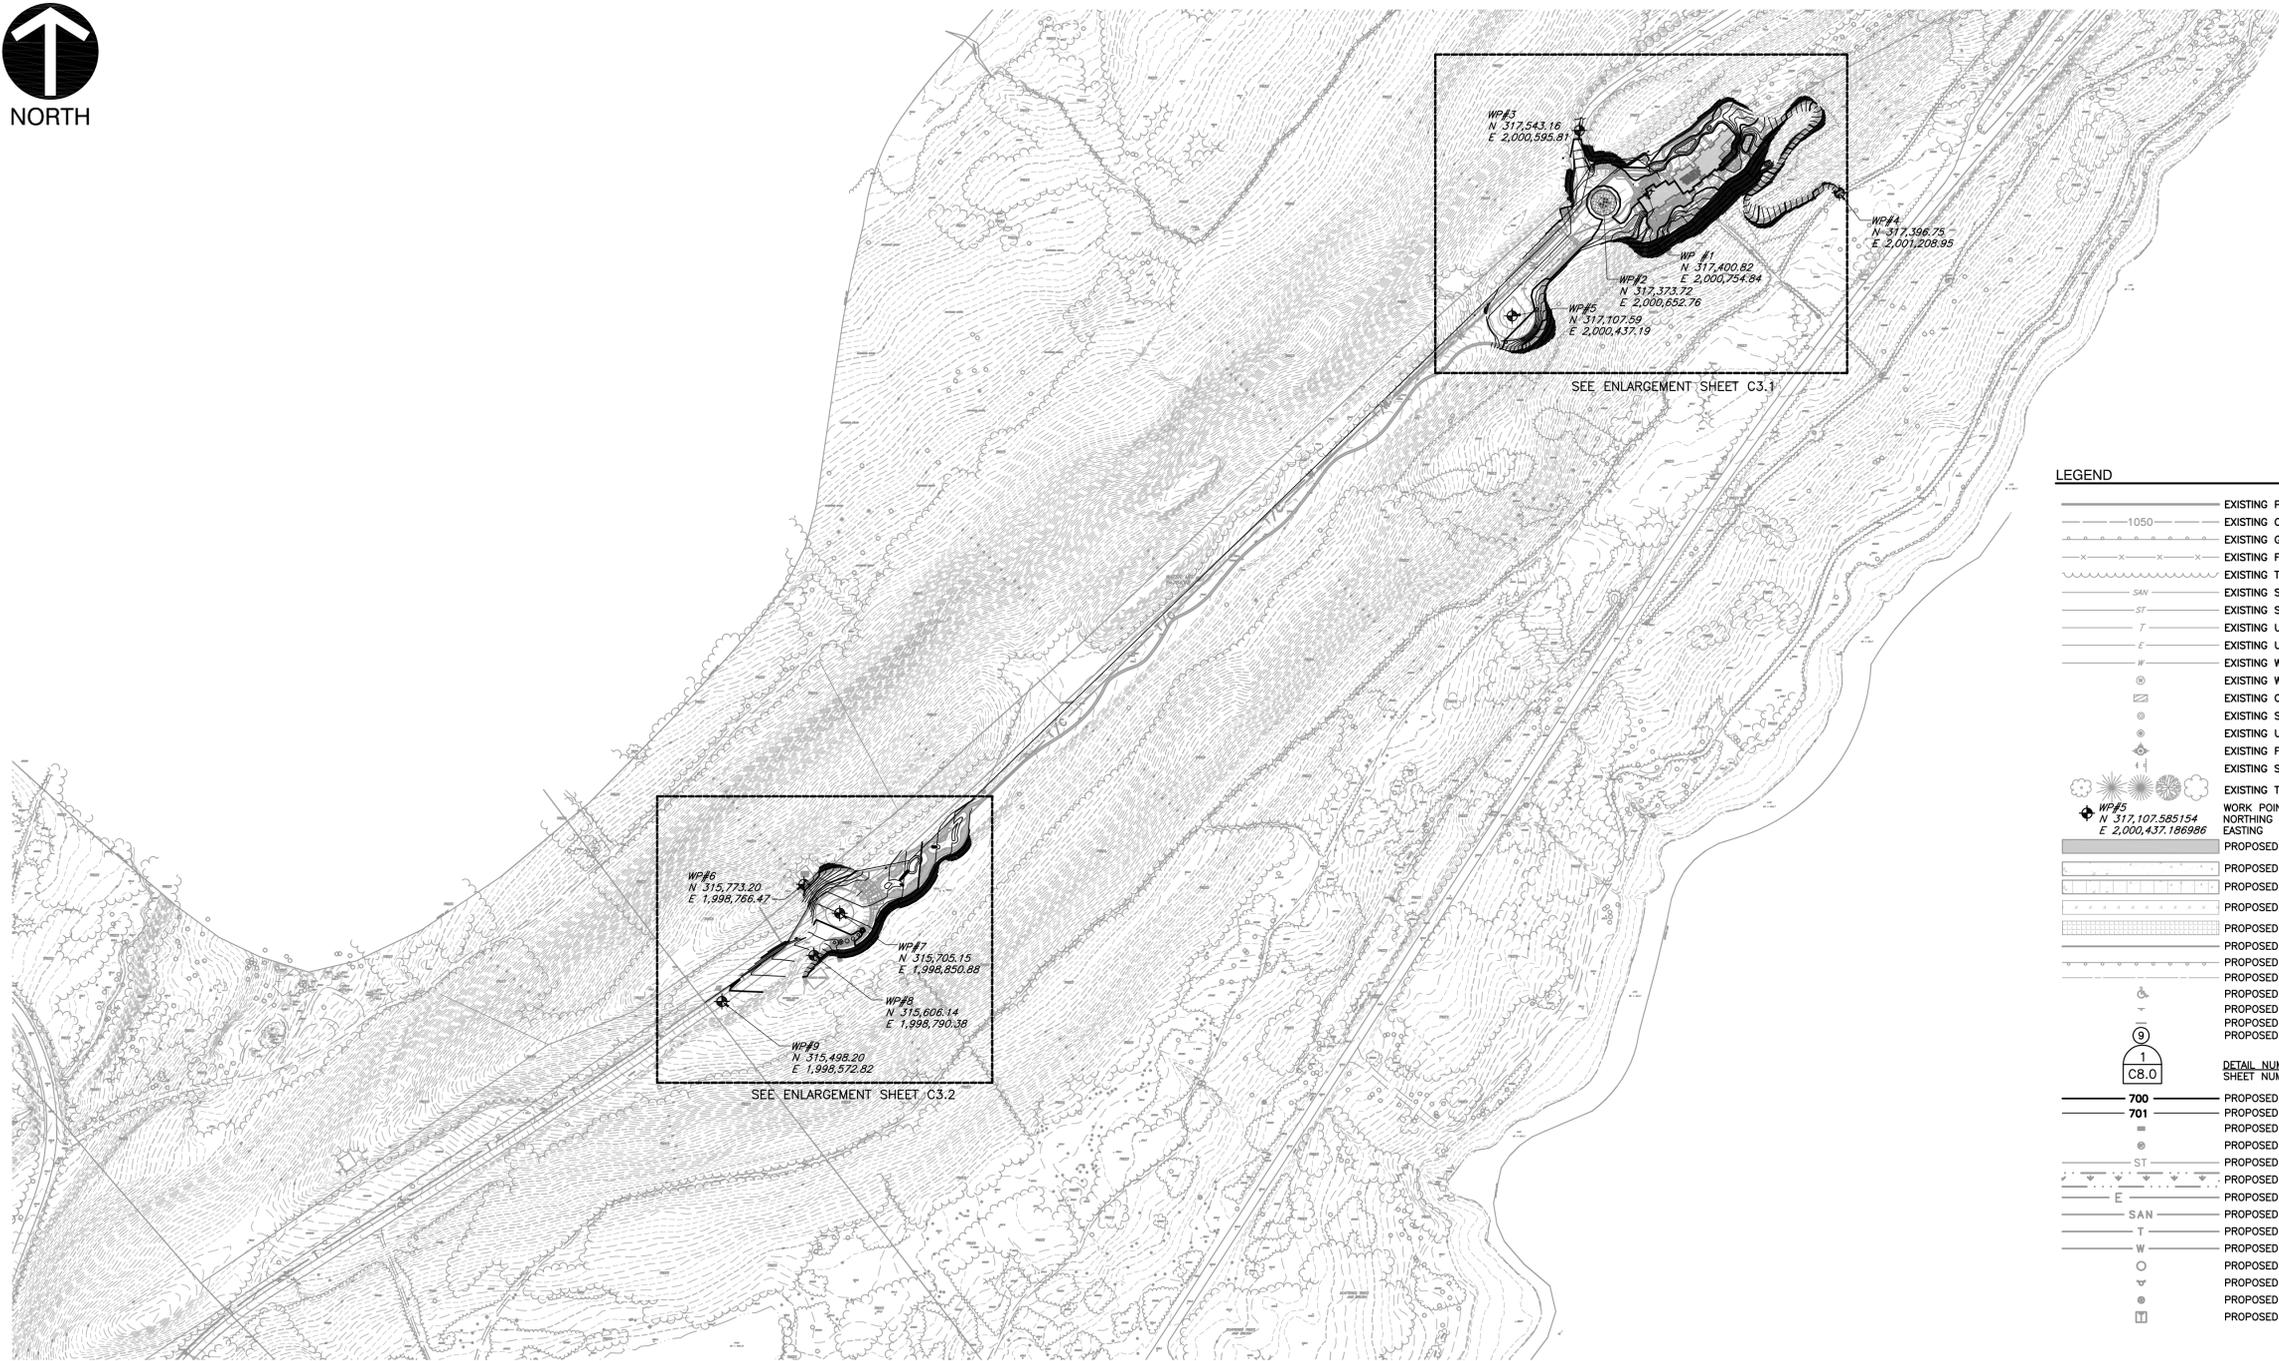

LEGEND

- EXISTING PROPERTY BOUNDARY
- EXISTING CONTOUR
- EXISTING GUIDE RAIL
- EXISTING FENCE
- EXISTING TREE LINE
- EXISTING SANITARY SEWER LINE
- EXISTING STORM SEWER LINE
- EXISTING UNDERGROUND TELEPHONE LINE
- EXISTING UNDERGROUND ELECTRIC LINE
- EXISTING WATER LINE
- EXISTING WATER BASIN
- EXISTING CATCH BASIN
- EXISTING SANITARY MANHOLE
- EXISTING UTILITY MANHOLE
- EXISTING FIRE HYDRANT
- EXISTING SIGN
- EXISTING TREE
- WORK POINT
- NORTHING
- EASTING
- PROPOSED BUILDING
- PROPOSED CONCRETE PAD
- PROPOSED CONCRETE WALKWAY
- PROPOSED REINFORCED TURF PARKING
- PROPOSED HIKING TRAIL
- PROPOSED BRIDGE
- PROPOSED GUIDE RAIL
- PROPOSED CENTERLINE
- PROPOSED ADA PARKING
- PROPOSED SIGN
- PROPOSED WHEEL STOP
- PROPOSED PARKING COUNT
- DETAIL NUMBER SHEET NUMBER
- PROPOSED INDEX CONTOUR
- PROPOSED INTERMEDIATE CONTOUR
- PROPOSED INLET
- PROPOSED STORM MANHOLE
- PROPOSED STORM SEWER
- PROPOSED BIORETENTION AREAS
- PROPOSED ELECTRIC LINE
- PROPOSED SANITARY SEWER
- PROPOSED TELEPHONE LINE
- PROPOSED WATER LINE
- PROPOSED SANITARY MANHOLE
- PROPOSED HYDRANT
- PROPOSED VALVE
- PROPOSED TRANSFORMER PAD

NOTES

- EXISTING CONDITIONS AS DEPICTED ON THESE PLANS ARE GENERAL AND ILLUSTRATIVE IN NATURE. IT IS THE RESPONSIBILITY OF THE CONTRACTOR TO EXAMINE THE SITE AND BE FAMILIAR WITH EXISTING CONDITIONS PRIOR TO BIDDING ON THIS PROJECT. IF CONDITIONS ENCOUNTERED DURING EXAMINATION ARE SIGNIFICANTLY DIFFERENT THAN THOSE SHOWN, THE CONTRACTOR SHALL NOTIFY THE DEPARTMENT IMMEDIATELY.
- ALL EXISTING ABOVE AND BELOW GROUND STRUCTURES WITHIN THE LIMITS OF CONSTRUCTION SHALL BE REMOVED UNLESS NOTED OTHERWISE WITHIN THIS CONSTRUCTION SET AND/OR PROJECT SPECIFICATIONS. THIS INCLUDES FOUNDATION SLABS, WALLS AND FOOTINGS. IN ADDITION, ALL EXISTING UTILITY SERVICES TO BUILDINGS SHALL BE DISCONNECTED AND TERMINATED PER EACH UTILITY COMPANY'S REQUIREMENTS.
- ALL WORK PERFORMED BY THE CONTRACTOR SHALL CONFORM TO THE LATEST REGULATIONS OF THE AMERICANS WITH DISABILITIES ACT. CONTRACTOR SHALL ALSO CONTACT PENNSYLVANIA ONE CALL SYSTEM, INC. AT 800-242-1776 AND THE APPROPRIATE UTILITY COMPANIES AT LEAST THREE (3) DAYS PRIOR TO THE INITIATION OF EARTH MOVING AND DEMOLITION ACTIVITIES.
- THE CONTRACTOR SHALL INDEMNIFY AND HOLD HARMLESS THE DEPARTMENT FOR ANY AND ALL INJURIES AND/OR DAMAGES TO PERSONNEL, EQUIPMENT AND/OR EXISTING FACILITIES OCCURRING IN THE COURSE OF THE DEMOLITION AND CONSTRUCTION DESCRIBED IN THE PLANS AND SPECIFICATIONS.
- PROJECT LIMIT LINE IS DEFINED IN THE APPROVED EROSION AND SEDIMENTATION CONTROL PLAN. SEE SHEET C9.0-C9.5

REFERENCES

- EXISTING TOPOGRAPHY PREPARED BY NOR EAST MAPPING, INC. JOB# NEM08006 DATE OF PHOTOGRAPHY: JAN 31, 2008 BALDEAGLE.DWG
- EXISTING SUBSURFACE SANITARY SEWER INFORMATION INTERPRETED FROM DRAWING TITLED SANITARY SEWER REHABILITATION BALD EAGLE STATE PARK PLAN AND DETAIL FROM PROJECT NO. MM 91-6133A DATED SEP 1991
- EXISTING SUBSURFACE WATER LINE AND ELECTRIC LINE INFORMATION INTERPRETED FROM DRAWING TITLED FOSTER JOSEPH SAVERS RESERVOIR SANITARY SYSTEMS FOR PUBLIC USE FACILITIES BALD EAGLE STATE PARK GENERAL PLAN DATED SEP 1973

ONE CALL SERIAL NO.: 0925482

CALL BEFORE YOU DIG!
 PENNSYLVANIA LAW REQUIRES
 3 WORKING DAYS NOTICE FOR
 CONSTRUCTION PHASE AND 10 WORKING
 DAYS IN DESIGN STAGE-STOP CALL
 PENNSYLVANIA ONE CALL SYSTEM, INC.
 1-800-242-1776

PENNSYLVANIA ACT 38 (1991) REQUIRES NO LESS THAN 3 WORKING DAYS NOTICE NOR MORE THAN 10 WORKING DAYS NOTICE FROM EXCAVATORS WHO ARE ABOUT TO DIG, DRILL, BLAST, AUGER, BORE, GRADE, TRENCH, OR DEMOLISH WHEN IN THE CONSTRUCTION PHASE. FOR LOCATION REQUESTS IN THE STATE OF PENNSYLVANIA, CALL TOLL FREE 1-800-242-1776. UNDERGROUND UTILITIES HAVE BEEN PLOTTED FROM AVAILABLE INFORMATION AND THE LOCATION MUST BE CONSIDERED APPROXIMATE. OTHER UNDERGROUND UTILITIES MAY EXIST WHICH ARE NOT SHOWN. IT WILL BE THE CONTRACTOR'S RESPONSIBILITY TO ASCERTAIN ALL PHYSICAL LOCATIONS OF UTILITY LINES PRIOR TO THE TIME OF CONSTRUCTION. IN NO WAY SHALL THE CONTRACTOR HOLD THE SURVEYOR RESPONSIBLE FOR ANY UTILITY LOCATION SHOWN ON THIS PLAN.

CEC
 Civil & Environmental Consultants, Inc.
 333 Baldwin Road - Pittsburgh, PA 15205-9072
 Ph: 412.429.2324 - 800.365.2324 - Fax: 412.429.2114
 www.cecinc.com

PROJECT NUMBER
070-915

NO.	DATE	REVISION	APPR.
1	09/08/08	ISSUED FOR ADDENDUM	

PROJECT DESIGNER	PROJECT COORDINATOR
APPROVED	APPROVED
CHIEF - DIVISION OF DESIGN	
APPROVED	
DIRECTOR - BUREAU OF FACILITY DESIGN AND CONSTRUCTION	

AS-BUILT
 THIS RECORD DRAWING HAS BEEN PREPARED ON INFORMATION PROVIDED BY OTHERS. THE DESIGN PROFESSIONAL HAS NOT VERIFIED THE ACCURACY AND/OR COMPLETENESS OF THIS INFORMATION AND SHALL NOT BE RESPONSIBLE FOR ANY ERRORS OR OMISSIONS WHICH MAY BE INCORPORATED HEREIN AS A RESULT.

COMMONWEALTH OF PENNSYLVANIA
 DEPARTMENT OF CONSERVATION AND NATURAL RESOURCES
 OFFICE OF PARKS AND FORESTRY

PROJECT NO: FDC-133-4494

APPLICABLE CONTRACT NO'S.

GENERAL: FDC-133-4494.1	PLUMBING:
HVAC:	ELECTRICAL:
ROADWAY:	



THE INN AT BALD EAGLE STATE PARK
 HOWARD AND LIBERTY TOWNSHIP,
 CENTRE COUNTY, PENNSYLVANIA

OVERALL
 GRADING PLAN

DRAWN BY: TAF	DATE: 09/18/08	DRAWING NO: C3.0
CHECKED BY: MWT	SCALE: 1"=200'	

G:\Projects\2007\070-915\dwg\AS BUILT\SD070-915-C30.dwg, C:30, 10/5/2010 10:01:55 AM, krampton

* SIGNATURE ON FILE

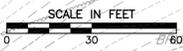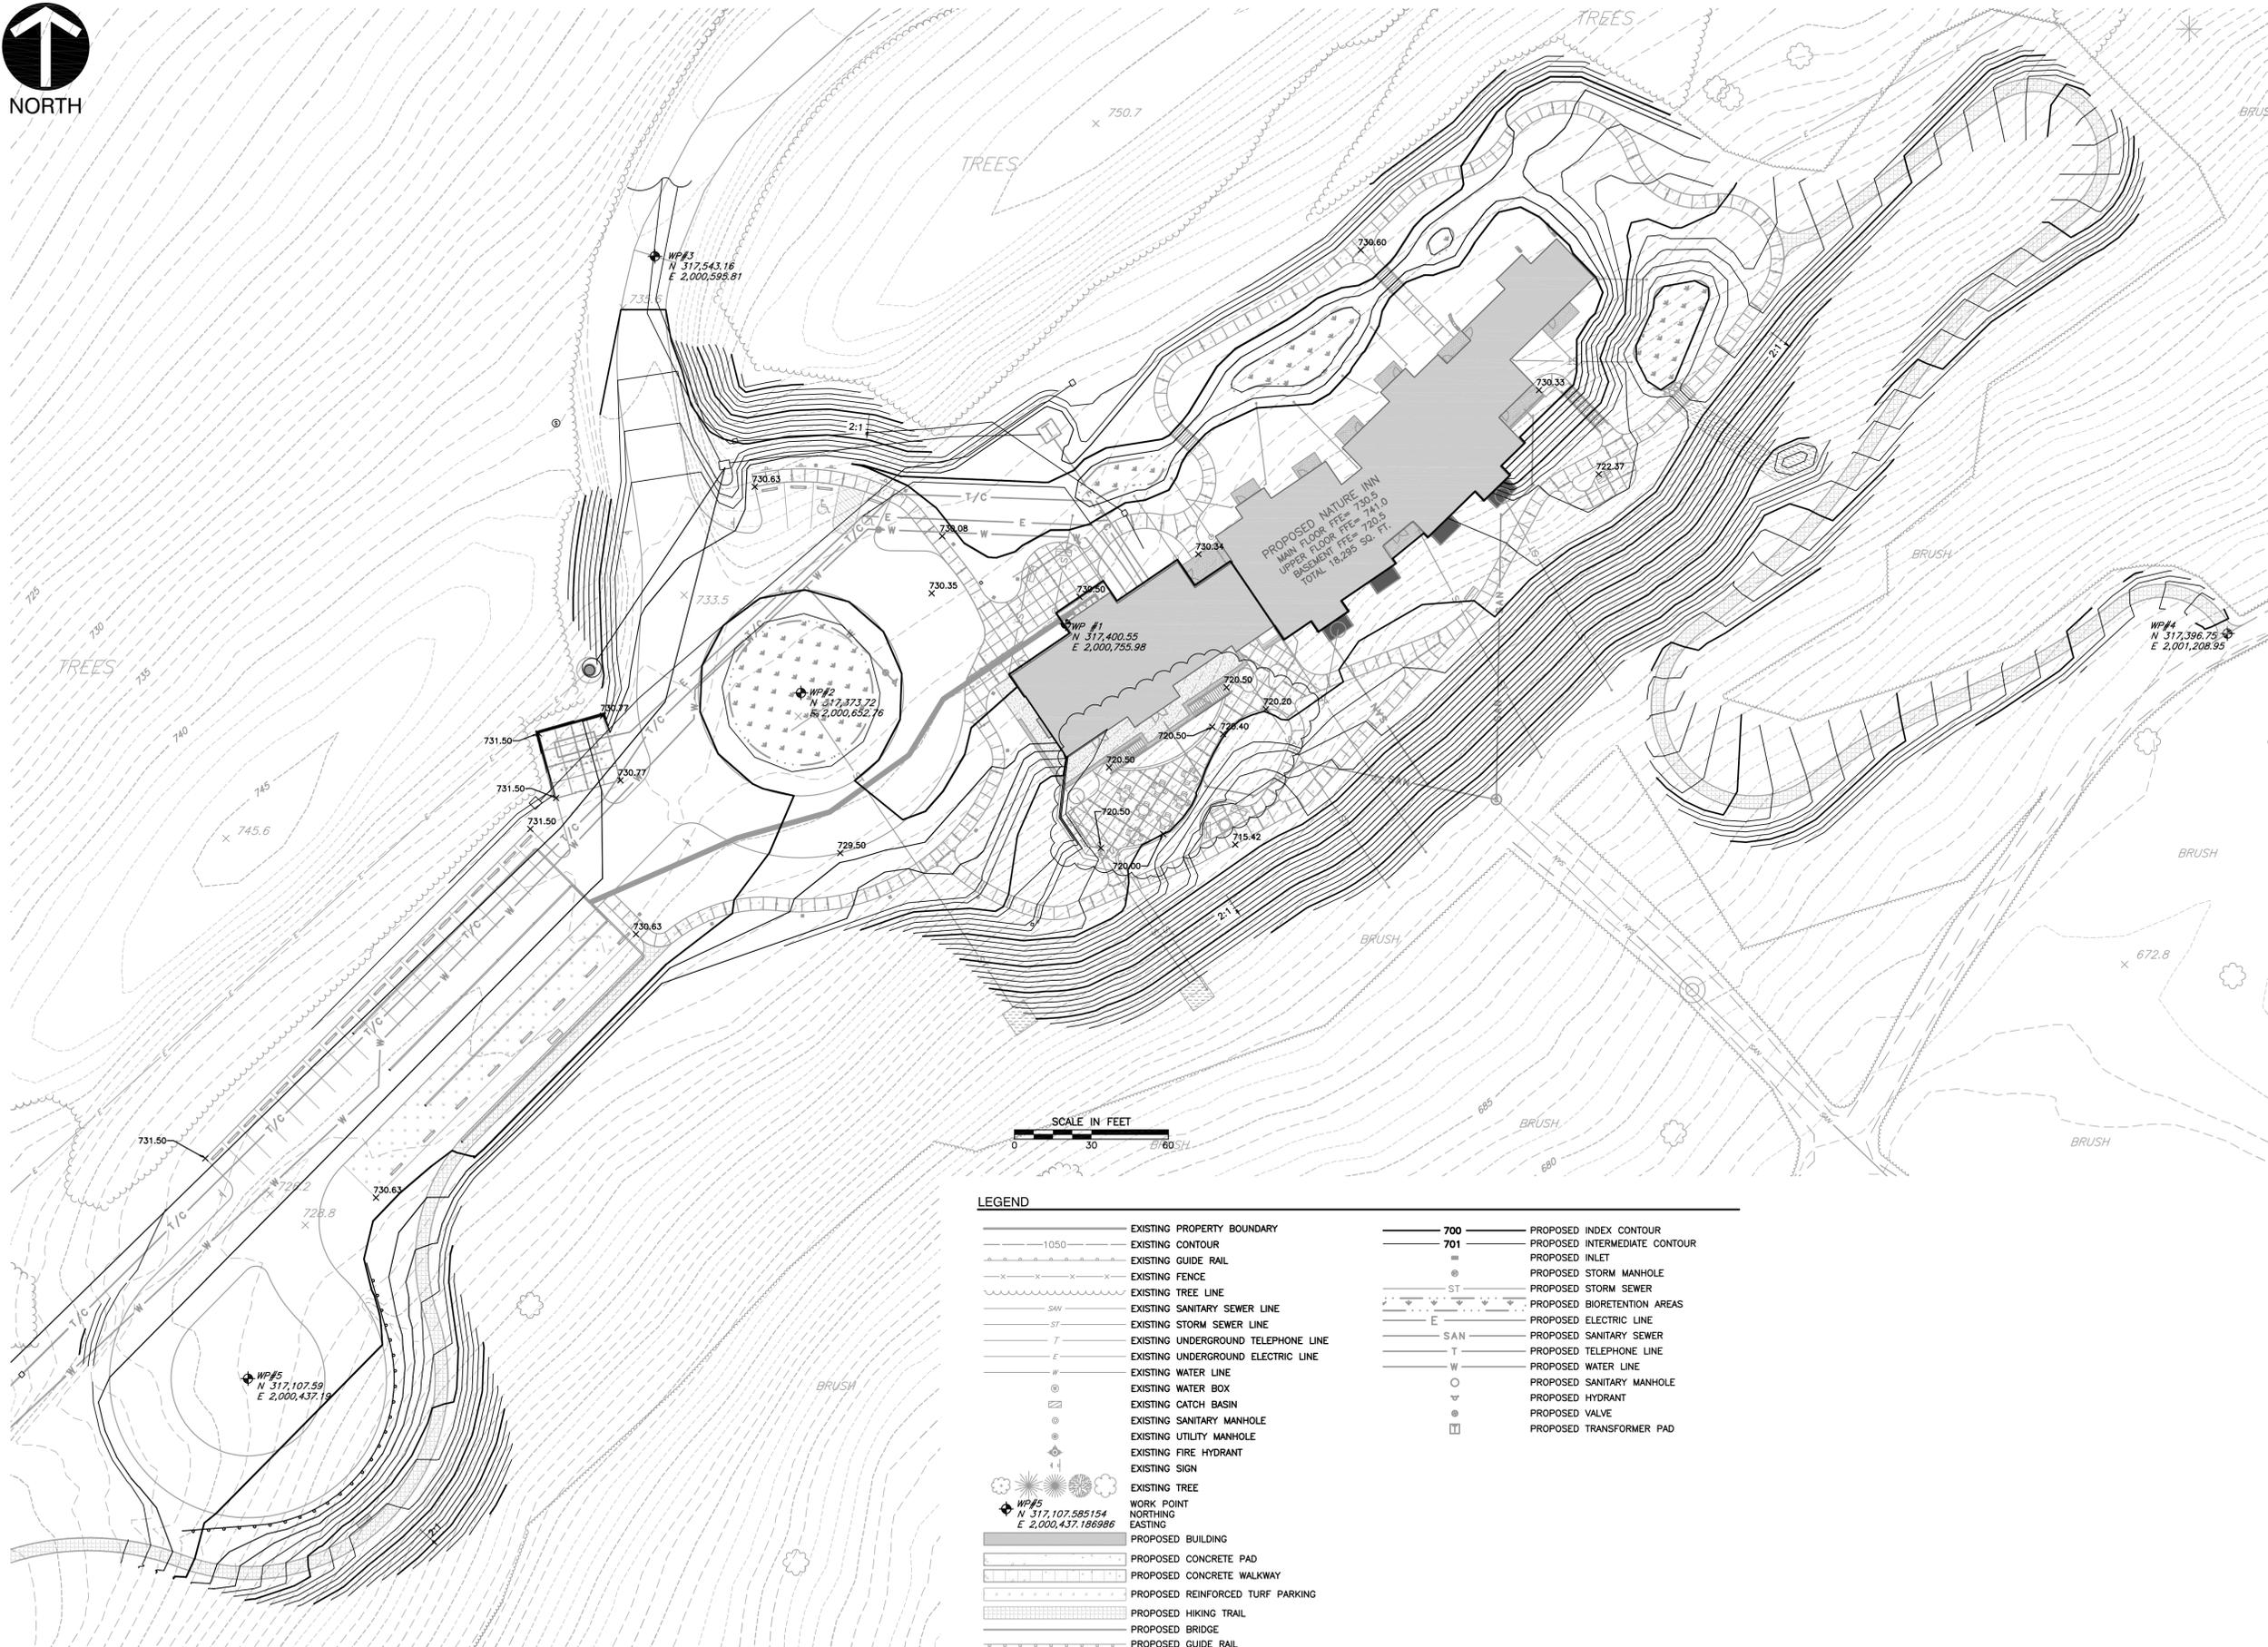

LEGEND

	EXISTING PROPERTY BOUNDARY		PROPOSED INDEX CONTOUR
	EXISTING CONTOUR		PROPOSED INTERMEDIATE CONTOUR
	EXISTING GUIDE RAIL		PROPOSED INLET
	EXISTING FENCE		PROPOSED STORM MANHOLE
	EXISTING TREE LINE		PROPOSED STORM SEWER
	EXISTING SANITARY SEWER LINE		PROPOSED BIORETENTION AREAS
	EXISTING STORM SEWER LINE		PROPOSED ELECTRIC LINE
	EXISTING UNDERGROUND TELEPHONE LINE		PROPOSED SANITARY SEWER
	EXISTING UNDERGROUND ELECTRIC LINE		PROPOSED TELEPHONE LINE
	EXISTING WATER LINE		PROPOSED WATER LINE
	EXISTING WATER BOX		PROPOSED SANITARY MANHOLE
	EXISTING CATCH BASIN		PROPOSED HYDRANT
	EXISTING SANITARY MANHOLE		PROPOSED VALVE
	EXISTING UTILITY MANHOLE		PROPOSED TRANSFORMER PAD
	EXISTING FIRE HYDRANT		
	EXISTING SIGN		
	EXISTING TREE		
	WORK POINT		
	NORTHING		
	EASTING		
	PROPOSED BUILDING		
	PROPOSED CONCRETE PAD		
	PROPOSED CONCRETE WALKWAY		
	PROPOSED REINFORCED TURF PARKING		
	PROPOSED HIKING TRAIL		
	PROPOSED BRIDGE		
	PROPOSED GUIDE RAIL		
	PROPOSED CENTERLINE		
	PROPOSED ADA PARKING		
	PROPOSED SIGN		
	PROPOSED WHEEL STOP		
	PROPOSED PARKING COUNT		
	DETAIL NUMBER		
	SHEET NUMBER		

NOTES

- EXISTING CONDITIONS AS DEPICTED ON THESE PLANS ARE GENERAL AND ILLUSTRATIVE IN NATURE. IT IS THE RESPONSIBILITY OF THE CONTRACTOR TO EXAMINE THE SITE AND BE FAMILIAR WITH EXISTING CONDITIONS PRIOR TO BIDDING ON THIS PROJECT. IF CONDITIONS ENCOUNTERED DURING EXAMINATION ARE SIGNIFICANTLY DIFFERENT THAN THOSE SHOWN, THE CONTRACTOR SHALL NOTIFY THE DEPARTMENT IMMEDIATELY.
- ALL EXISTING ABOVE AND BELOW GROUND STRUCTURES WITHIN THE LIMITS OF CONSTRUCTION SHALL BE REMOVED UNLESS NOTED OTHERWISE WITHIN THIS CONSTRUCTION SET AND/OR PROJECT SPECIFICATIONS. THIS INCLUDES FOUNDATION SLABS, WALLS AND FOOTINGS. IN ADDITION, ALL EXISTING UTILITY SERVICES TO BUILDINGS SHALL BE DISCONNECTED AND TERMINATED PER EACH UTILITY COMPANY'S REQUIREMENTS.
- ALL WORK PERFORMED BY THE CONTRACTOR SHALL CONFORM TO THE LATEST REGULATIONS OF THE AMERICANS WITH DISABILITIES ACT. CONTRACTOR SHALL ALSO CONTACT PENNSYLVANIA ONE CALL SYSTEM, INC. AT 800-242-1776 AND THE APPROPRIATE UTILITY COMPANIES AT LEAST THREE (3) DAYS PRIOR TO THE INITIATION OF EARTH MOVING AND DEMOLITION ACTIVITIES.
- THE CONTRACTOR SHALL INDEMNIFY AND HOLD HARMLESS THE DEPARTMENT FOR ANY AND ALL INJURIES AND/OR DAMAGES TO PERSONNEL, EQUIPMENT AND/OR EXISTING FACILITIES OCCURRING IN THE COURSE OF THE DEMOLITION AND CONSTRUCTION DESCRIBED IN THE PLANS AND SPECIFICATIONS.
- PROJECT LIMIT LINE IS DEFINED IN THE APPROVED EROSION AND SEDIMENTATION CONTROL PLAN. SEE SHEET C9.0-C9.5

REFERENCES

- EXISTING TOPOGRAPHY PREPARED BY NOR EAST MAPPING, INC. JOB# NEM08006 DATE OF PHOTOGRAPHY: JAN 31, 2008 BALDEAGLE.DWG
- EXISTING SUBSURFACE SANITARY SEWER INFORMATION INTERPRETED FROM DRAWING TITLED SANITARY SEWER REHABILITATION BALD EAGLE STATE PARK PLAN AND DETAIL FROM PROJECT NO. MM 91-6133A DATED SEP 1991
- EXISTING SUBSURFACE WATER LINE AND ELECTRIC LINE INFORMATION INTERPRETED FROM DRAWING TITLED FOSTER JOSEPH SAYERS RESERVOIR SANITARY SYSTEMS FOR PUBLIC USE FACILITIES BALD EAGLE STATE PARK GENERAL PLAN DATED SEP 1973

ONE CALL SERIAL NO.: 0925482

CALL BEFORE YOU DIG!
 PENNSYLVANIA LAW REQUIRES
 3 WORKING DAYS NOTICE FOR
 CONSTRUCTION PHASE AND 10 WORKING
 DAYS IN DESIGN STAGE-STOP CALL
 PENNSYLVANIA ONE CALL SYSTEM, INC.
 1-800-242-1776

PENNSYLVANIA ACT 38 (1991) REQUIRES NO LESS THAN 3 WORKING DAYS NOTICE NOR MORE THAN 10 WORKING DAYS NOTICE FROM EXCAVATORS WHO ARE ABOUT TO DIG, DRILL, BLAST, AUGER, BORE, GRADE, TRENCH, OR DEMOLISH WITHIN THE CONSTRUCTION PHASE. FOR LOCATION REQUESTS IN THE STATE OF PENNSYLVANIA, CALL TOLL FREE 1-800-242-1776. UNDERGROUND UTILITIES HAVE BEEN PLOTTED FROM AVAILABLE INFORMATION AND THE LOCATION MUST BE CONSIDERED APPROXIMATE. OTHER UNDERGROUND UTILITIES MAY EXIST WHICH ARE NOT SHOWN. IT WILL BE THE CONTRACTOR'S RESPONSIBILITY TO ASCERTAIN ALL PHYSICAL LOCATIONS OF UTILITY LINES PRIOR TO THE TIME OF CONSTRUCTION. IN NO WAY SHALL THE CONTRACTOR HOLD THE SURVEYOR RESPONSIBLE FOR ANY UTILITY LOCATION SHOWN ON THIS PLAN.

CEC
Civil & Environmental Consultants, Inc.
 333 Baldwin Road - Pittsburgh, PA 15205-9072
 Ph: 412.429.2324 • 800.365.2324 • Fax: 412.429.2114
 www.cecinc.com

PROJECT NUMBER
070-915

NO.	DATE	REVISION	APPR.
1	09/08/08	ISSUED FOR ADDENDUM	
SUBMITTED			
PROJECT DESIGNER		PROJECT COORDINATOR	
APPROVED			
CHIEF - DIVISION OF DESIGN			
APPROVED			
DIRECTOR - BUREAU OF FACILITY DESIGN AND CONSTRUCTION			

AS-BUILT
 THIS RECORD DRAWING HAS BEEN PREPARED ON INFORMATION PROVIDED BY OTHERS. THE DESIGN PROFESSIONAL HAS NOT VERIFIED THE ACCURACY AND/OR COMPLETENESS OF THIS INFORMATION AND SHALL NOT BE RESPONSIBLE FOR ANY ERRORS OR OMISSIONS WHICH MAY BE INCORPORATED HEREIN AS A RESULT.

COMMONWEALTH OF PENNSYLVANIA
 DEPARTMENT OF CONSERVATION AND NATURAL RESOURCES
 OFFICE OF PARKS AND FORESTRY

PROJECT NO: FDC-133-4494
 APPLICABLE CONTRACT NO'S.

GENERAL:	FDC-133-4494.1	PLUMBING:	
HVAC:		ELECTRICAL:	
ROADWAY:			


THE INN AT BALD EAGLE STATE PARK
 HOWARD AND LIBERTY TOWNSHIP,
 CENTRE COUNTY, PENNSYLVANIA

ENLARGED GRADING PLAN

DRAWN BY:	TAF	DATE:	09/18/08	DRAWING NO.:	C3.1
CHECKED BY:	MWT	SCALE:	1"=30'		

* SIGNATURE ON FILE

G:\Projects\2007\070-915\dwg\AS BUILT\070-915-C30.dwg, C31, 10/5/2010 10:01:37 AM, krampton

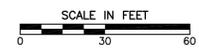

LEGEND

- 1050 --- EXISTING PROPERTY BOUNDARY
- - - - - EXISTING CONTOUR
- - - - - EXISTING GUIDE RAIL
- - - - - EXISTING FENCE
- - - - - EXISTING TREE LINE
- - - - - EXISTING SANITARY SEWER LINE
- - - - - EXISTING STORM SEWER LINE
- - - - - EXISTING UNDERGROUND TELEPHONE LINE
- - - - - EXISTING UNDERGROUND ELECTRIC LINE
- - - - - EXISTING WATER LINE
- ⊕ EXISTING WATER BOX
- ⊕ EXISTING CATCH BASIN
- ⊕ EXISTING SANITARY MANHOLE
- ⊕ EXISTING UTILITY MANHOLE
- ⊕ EXISTING FIRE HYDRANT
- ⊕ EXISTING SIGN
- ⊕ EXISTING TREE
- ⊕ WP#5 N 317,107.585154 E 2,000,437.186986 WORK POINT NORTHING EASTING
- ▭ PROPOSED BUILDING
- ▭ PROPOSED CONCRETE PAD
- ▭ PROPOSED CONCRETE WALKWAY
- ▭ PROPOSED REINFORCED TURF PARKING
- ▭ PROPOSED HIKING TRAIL
- ▭ PROPOSED BRIDGE
- ▭ PROPOSED GUIDE RAIL
- ▭ PROPOSED CENTERLINE
- ▭ PROPOSED ADA PARKING
- ▭ PROPOSED SIGN
- ▭ PROPOSED WHEEL STOP
- ▭ PROPOSED PARKING COUNT
- Ⓢ DETAIL NUMBER SHEET NUMBER
- 700 PROPOSED INDEX CONTOUR
- 701 PROPOSED INTERMEDIATE CONTOUR
- ⊕ PROPOSED INLET
- ⊕ PROPOSED STORM MANHOLE
- ⊕ PROPOSED STORM SEWER
- ⊕ PROPOSED BIOTENTION AREAS
- ⊕ PROPOSED ELECTRIC LINE
- SAN PROPOSED SANITARY SEWER
- T PROPOSED TELEPHONE LINE
- W PROPOSED WATER LINE
- ⊕ PROPOSED SANITARY MANHOLE
- ⊕ PROPOSED HYDRANT
- ⊕ PROPOSED VALVE
- ⊕ PROPOSED TRANSFORMER PAD

NOTES

1. EXISTING CONDITIONS AS DEPICTED ON THESE PLANS ARE GENERAL AND ILLUSTRATIVE IN NATURE. IT IS THE RESPONSIBILITY OF THE CONTRACTOR TO EXAMINE THE SITE AND BE FAMILIAR WITH EXISTING CONDITIONS PRIOR TO BIDDING ON THIS PROJECT. IF CONDITIONS ENCOUNTERED DURING EXAMINATION ARE SIGNIFICANTLY DIFFERENT THAN THOSE SHOWN, THE CONTRACTOR SHALL NOTIFY THE DEPARTMENT IMMEDIATELY.
2. ALL EXISTING ABOVE AND BELOW GROUND STRUCTURES WITHIN THE LIMITS OF CONSTRUCTION SHALL BE REMOVED UNLESS NOTED OTHERWISE WITHIN THIS CONSTRUCTION SET AND/OR PROJECT SPECIFICATIONS. THIS INCLUDES FOUNDATION SLABS, WALLS AND FOOTINGS. IN ADDITION, ALL EXISTING UTILITY SERVICES TO BUILDINGS SHALL BE DISCONNECTED AND TERMINATED PER EACH UTILITY COMPANY'S REQUIREMENTS.
3. ALL WORK PERFORMED BY THE CONTRACTOR SHALL CONFORM TO THE LATEST REGULATIONS OF THE AMERICANS WITH DISABILITIES ACT. CONTRACTOR SHALL ALSO CONTACT PENNSYLVANIA ONE CALL SYSTEM, INC. AT 800-242-1776 AND THE APPROPRIATE UTILITY COMPANIES AT LEAST THREE (3) DAYS PRIOR TO THE INITIATION OF EARTH MOVING AND DEMOLITION ACTIVITIES.
4. THE CONTRACTOR SHALL INDEMNIFY AND HOLD HARMLESS THE DEPARTMENT FOR ANY AND ALL INJURIES AND/OR DAMAGES TO PERSONNEL, EQUIPMENT AND/OR EXISTING FACILITIES OCCURRING IN THE COURSE OF THE DEMOLITION AND CONSTRUCTION DESCRIBED IN THE PLANS AND SPECIFICATIONS.
5. PROJECT LIMIT LINE IS DEFINED IN THE APPROVED EROSION AND SEDIMENTATION CONTROL PLAN. SEE SHEET C9.0-C9.5

REFERENCES

1. EXISTING TOPOGRAPHY PREPARED BY NOR EAST MAPPING, INC. JOB# MEM08006 DATE OF PHOTOGRAPHY: JAN 31, 2008 BALDEAGLE.DWG
2. EXISTING SUBSURFACE SANITARY SEWER INFORMATION INTERPRETED FROM DRAWING TITLED SANITARY SEWER REHABILITATION BALD EAGLE STATE PARK PLAN AND DETAIL FROM PROJECT NO. MM 91-6133A DATED SEP 1991
3. EXISTING SUBSURFACE WATER LINE AND ELECTRIC LINE INFORMATION INTERPRETED FROM DRAWING TITLED FOSTER JOSEPH SAVERS RESERVOIR SANITARY SYSTEMS FOR PUBLIC USE FACILITIES BALD EAGLE STATE PARK GENERAL PLAN DATED SEP 1973

ONE CALL SERIAL NO.: 0925482

CALL BEFORE YOU DIG!
 PENNSYLVANIA LAW REQUIRES 3 WORKING DAYS NOTICE FOR CONSTRUCTION PHASE AND 10 WORKING DAYS IN DESIGN STAGE-STOP CALL PENNSYLVANIA ONE CALL SYSTEM, INC. 1-800-242-1776

PENNSYLVANIA ACT 38 (1991) REQUIRES NO LESS THAN 3 WORKING DAYS NOTICE NOR MORE THAN 10 WORKING DAYS NOTICE FROM EXCAVATORS WHO ARE ABOUT TO DIG, DRILL, BLAST, AUGER, BORE, GRADE, RELOCATE, OR DEMOLISH WHEN IN THE CONSTRUCTION PHASE. FOR LOCATION REQUESTS IN THE STATE OF PENNSYLVANIA, CALL TOLL FREE 1-800-242-1776. UNDERGROUND UTILITIES HAVE BEEN PLOTTED FROM AVAILABLE INFORMATION AND THE LOCATION MUST BE CONSIDERED APPROXIMATE. OTHER UNDERGROUND UTILITIES MAY EXIST WHICH ARE NOT SHOWN. IT WILL BE THE CONTRACTOR'S RESPONSIBILITY TO ASCERTAIN ALL PHYSICAL LOCATIONS OF UTILITY LINES PRIOR TO THE TIME OF CONSTRUCTION. IN NO WAY SHALL THE CONTRACTOR HOLD THE SURVEYOR RESPONSIBLE FOR ANY UTILITY LOCATION SHOWN ON THIS PLAN.

CEC
 Civil & Environmental Consultants, Inc.
 333 Baldwin Road - Pittsburgh, PA 15205-9072
 Ph: 412.429.2324 • 800.365.2324 • Fax: 412.429.2114
 www.cecinc.com

PROJECT NUMBER 070-915

NO.	DATE	REVISION	APPR.
1	09/08/08	ISSUED FOR ADDENDUM	
SUBMITTED			
PROJECT DESIGNER		PROJECT COORDINATOR	
APPROVED			
CHIEF - DIVISION OF DESIGN			
APPROVED			
DIRECTOR - BUREAU OF FACILITY DESIGN AND CONSTRUCTION			

AS-BUILT
 THIS RECORD DRAWING HAS BEEN PREPARED ON INFORMATION PROVIDED BY OTHERS. THE DESIGN PROFESSIONAL HAS NOT VERIFIED THE ACCURACY AND/OR COMPLETENESS OF THIS INFORMATION AND SHALL NOT BE RESPONSIBLE FOR ANY ERRORS OR OMISSIONS WHICH MAY BE INCORPORATED HEREIN AS A RESULT.

COMMONWEALTH OF PENNSYLVANIA
 DEPARTMENT OF CONSERVATION AND NATURAL RESOURCES
 OFFICE OF PARKS AND FORESTRY

PROJECT NO: FDC-133-4494
 APPLICABLE CONTRACT NO'S.

GENERAL:	FDC-133-4494.1	PLUMBING:	
HVAC:		ELECTRICAL:	
ROADWAY:			

THE INN AT BALD EAGLE STATE PARK
 HOWARD AND LIBERTY TOWNSHIP,
 CENTRE COUNTY, PENNSYLVANIA


ENLARGED
 GRADING PLAN

DRAWN BY:	TAF	DATE:	09/18/08	DRAWING NO.:	
CHECKED BY:	MWT	SCALE:	1"=30'		

C3.2

* SIGNATURE ON FILE

G:\Projects\2007\070-915\dwg\AS BUILT\5070-915-C30.dwg, C32, 10/5/2010 10:01:17 AM, krampton

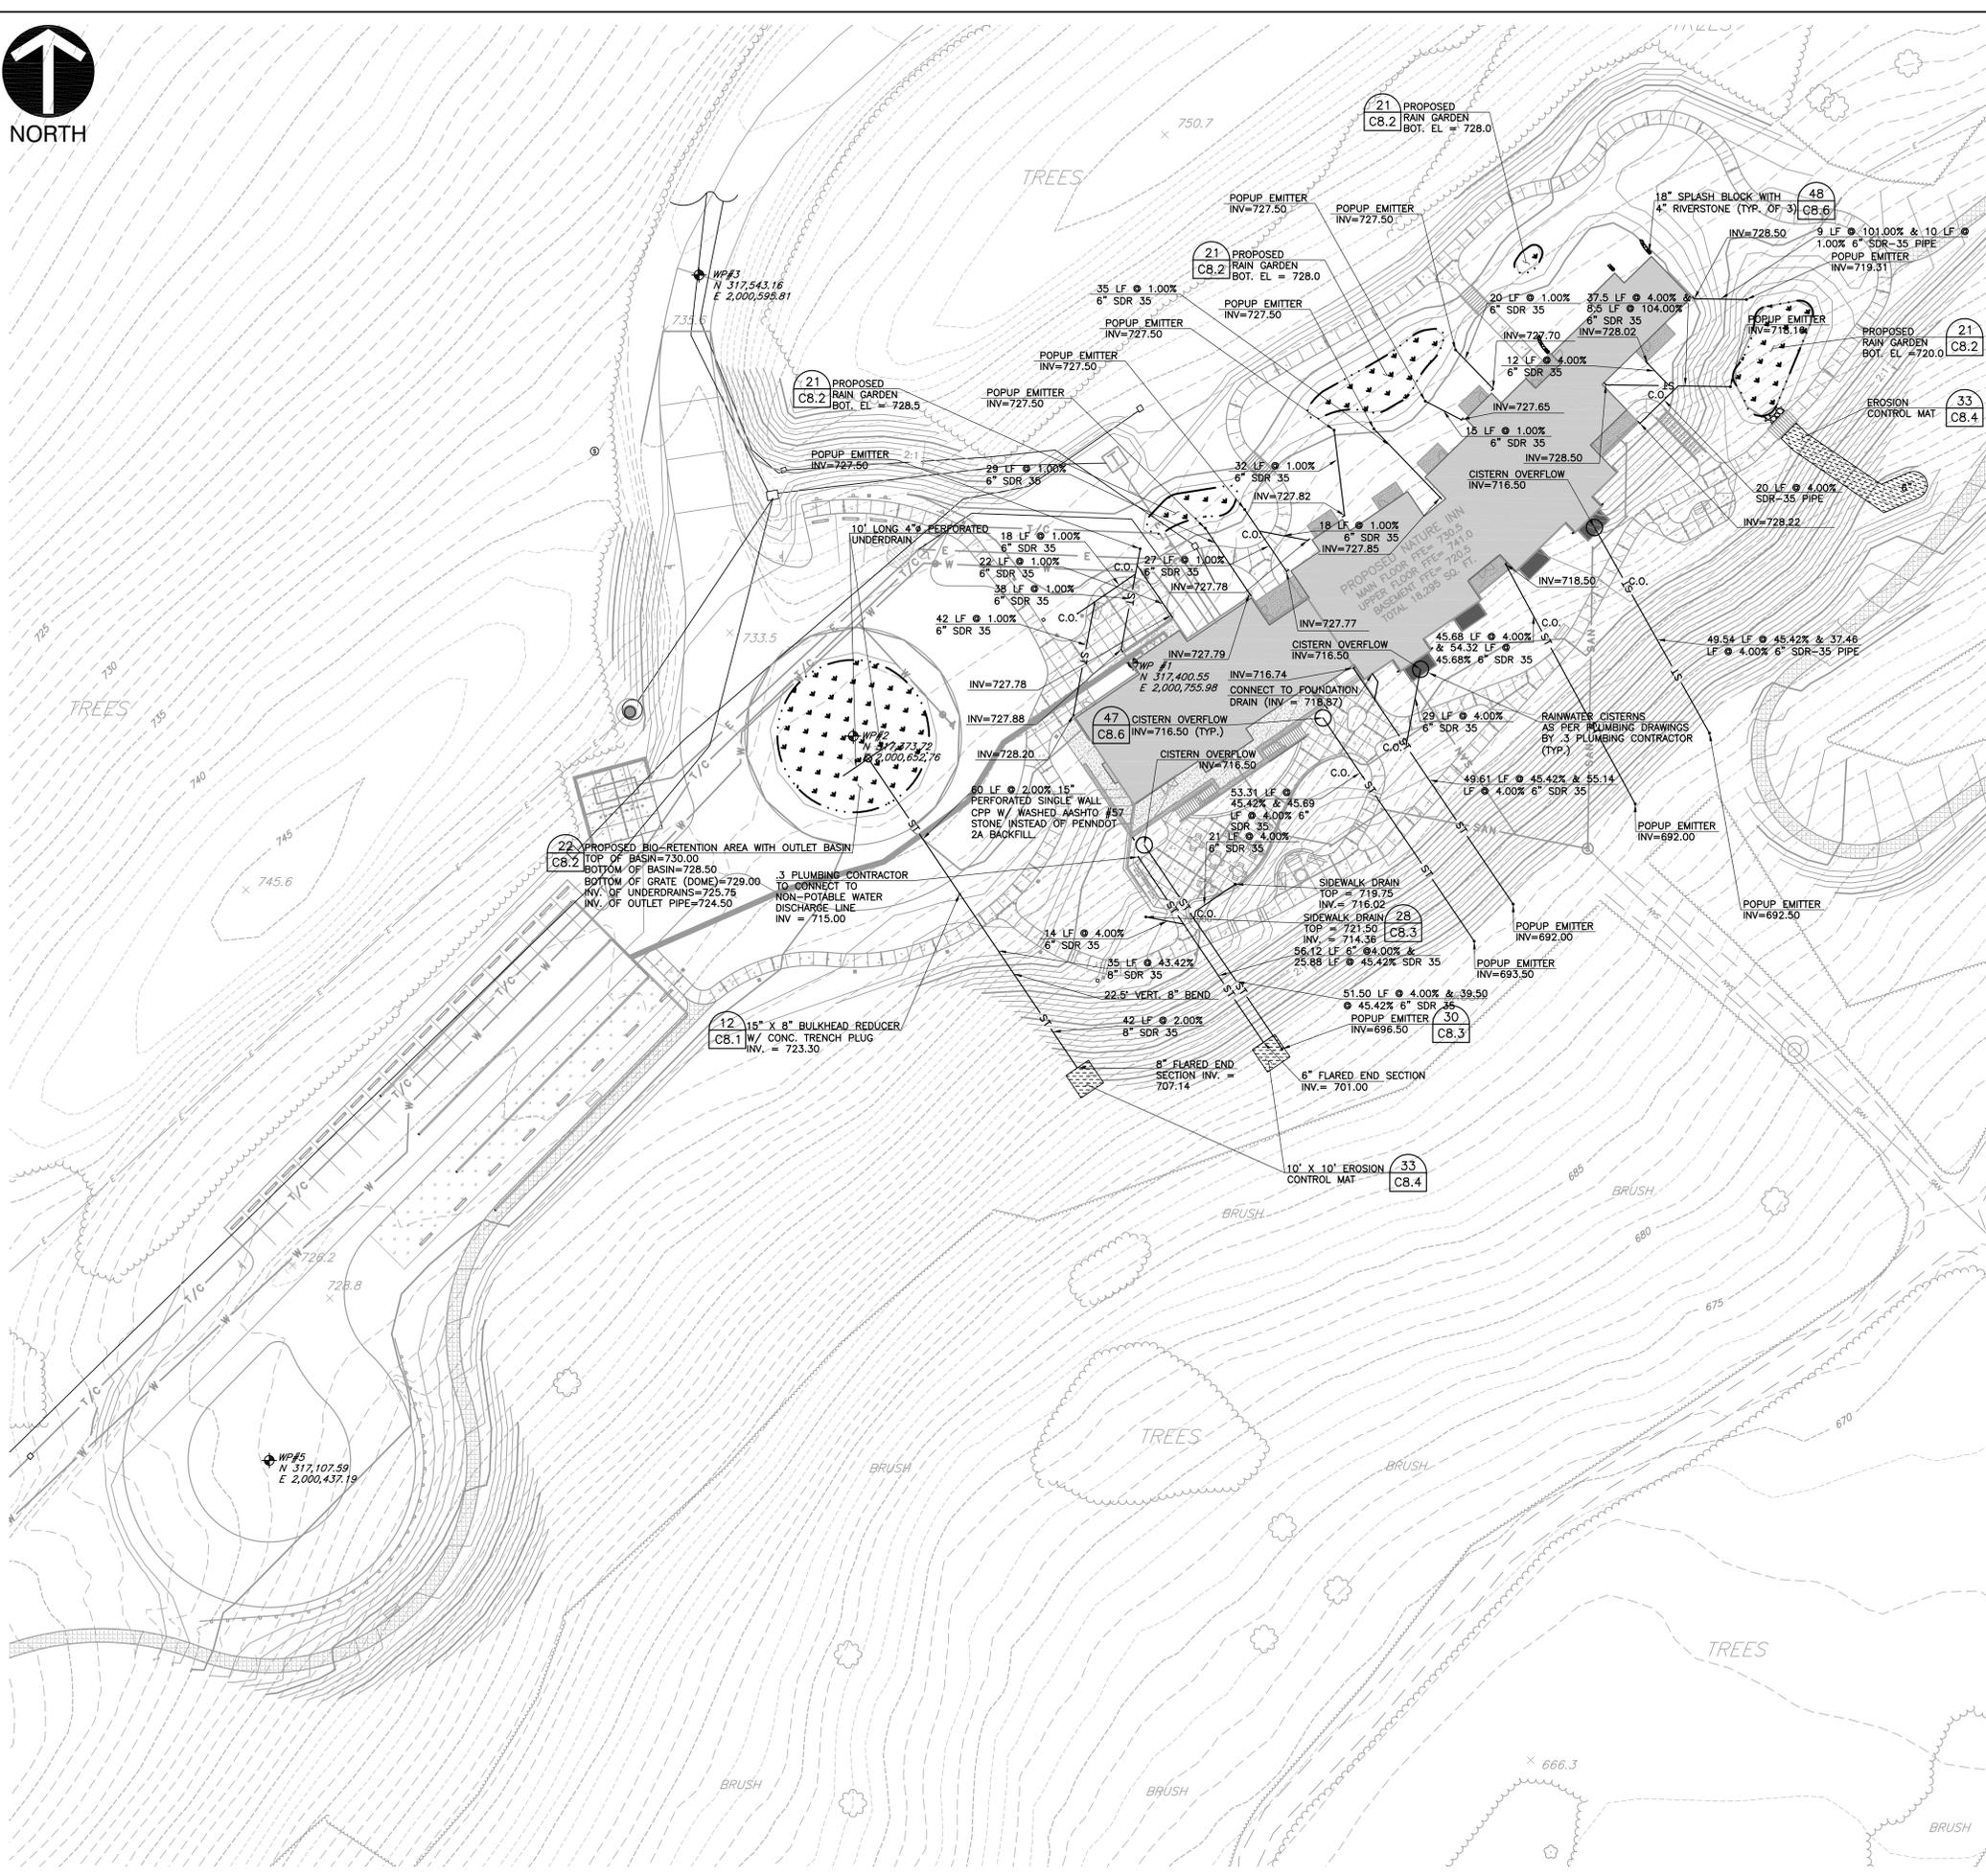

LEGEND

- 1050 — EXISTING PROPERTY BOUNDARY
- - - - - EXISTING CONTOUR
- - - - - EXISTING GUIDE RAIL
- - - - - EXISTING FENCE
- - - - - EXISTING TREE LINE
- - - - - EXISTING SANITARY SEWER LINE
- - - - - EXISTING STORM SEWER LINE
- - - - - EXISTING UNDERGROUND TELEPHONE LINE
- - - - - EXISTING UNDERGROUND ELECTRIC LINE
- - - - - EXISTING WATER LINE
- - - - - EXISTING WATER BOX
- - - - - EXISTING CATCH BASIN
- - - - - EXISTING SANITARY MANHOLE
- - - - - EXISTING UTILITY MANHOLE
- - - - - EXISTING FIRE HYDRANT
- - - - - EXISTING SIGN
- - - - - EXISTING TREE
- WP#5 N 317,107.59 E 2,000,437.19 WORK POINT NORTHING EASTING
- WP#3 N 317,543.16 E 2,000,598.81 WORK POINT NORTHING EASTING
- WP#2 N 317,733.72 E 2,000,652.76 WORK POINT NORTHING EASTING
- WP#1 N 317,400.55 E 2,000,755.98 WORK POINT NORTHING EASTING
- PROPOSED BUILDING
- PROPOSED CONCRETE PAD
- PROPOSED CONCRETE WALKWAY
- PROPOSED REINFORCED TURF PARKING
- PROPOSED HIKING TRAIL
- PROPOSED BRIDGE
- PROPOSED GUIDE RAIL
- PROPOSED CENTERLINE
- PROPOSED ADA PARKING
- PROPOSED SIGN
- PROPOSED WHEEL STOP
- PROPOSED PARKING STOP
- DETAIL NUMBER SHEET NUMBER
- 700 PROPOSED INDEX CONTOUR
- 701 PROPOSED INTERMEDIATE CONTOUR
- PROPOSED INLET
- PROPOSED STORM MANHOLE
- PROPOSED STORM SEWER
- PROPOSED BIORETENTION AREAS
- PROPOSED ELECTRIC LINE
- PROPOSED SANITARY SEWER
- PROPOSED TELEPHONE LINE
- PROPOSED WATER LINE
- PROPOSED SANITARY MANHOLE
- PROPOSED HYDRANT

GENERAL NOTES

1. ALL DEMOLITION WASTE AND CONSTRUCTION DEBRIS SHALL BE REMOVED BY THE CONTRACTOR AND DISPOSED OF IN A STATE APPROVED WASTE SITE REQUIREMENTS.
2. ALL UTILITY REMOVAL, RELOCATION, CUTTING, CAPPING AND/OR ABANDONMENT SHALL BE COORDINATED WITH THE APPROPRIATE UTILITY COMPANY. UTILITY CONTACTS ARE LISTED IN THE SPECIFICATIONS.
3. THE BURNING OF CLEARED MATERIAL AND DEBRIS SHALL NOT BE ALLOWED.
4. EROSION AND SEDIMENTATION CONTROL MEASURES AROUND AREAS OF DEMOLITION SHALL BE INSTALLED PRIOR TO INITIALIZATION OF DEMOLITION ACTIVITIES.
5. ASBESTOS OR HAZARDOUS MATERIALS, IF FOUND ON SITE, SHALL BE REMOVED BY A LICENSED HAZARDOUS MATERIALS CONTRACTOR. CONTRACTOR SHALL NOTIFY OWNER IMMEDIATELY IF HAZARDOUS MATERIALS ARE ENCOUNTERED.
6. CONTRACTOR SHALL ADHERE TO ALL LOCAL, STATE, FEDERAL AND OSHA REGULATIONS DURING ALL DEMOLITION ACTIVITIES.
7. CONTRACTOR SHALL PROTECT ALL CORNER PINS, MONUMENTS, PROPERTY CORNERS AND BENCHMARKS DURING DEMOLITION ACTIVITIES. IF DISTURBED, CONTRACTOR SHALL HAVE DISTURBED ITEMS RESET BY A LICENSED SURVEYOR AT NO ADDITIONAL COST TO THE OWNER.
8. CONTRACTOR SHALL PROVIDE AND MAINTAIN TRAFFIC CONTROL MEASURES IN ACCORDANCE WITH PENNDOT PUBLICATION 203 (WORK ZONE TRAFFIC CONTROL) AND AS REQUIRED BY LOCAL AGENCIES WHEN WORKING IN AND/OR ALONG STREETS, ROADS, HIGHWAYS, ETC. IT SHALL BE THE CONTRACTOR'S RESPONSIBILITY TO OBTAIN APPROVAL AND COORDINATE WITH LOCAL AND/OR STATE AGENCIES REGARDING THE NEED, EXTENT AND LIMITATIONS ASSOCIATED WITH INSTALLING AND MAINTAINING TRAFFIC CONTROL MEASURES.
9. ALL PAVEMENT SAW CUTS SHALL BE STRAIGHT, SMOOTH AND CLEAN CUTS.

MAINTENANCE NOTES

- ALL PERMANENT STORMWATER MANAGEMENT FACILITIES SHALL BE MAINTAINED IN GOOD WORKING ORDER BY THE DEPARTMENT. TYPICAL MAINTENANCE PROCEDURES FOR A STORMWATER COLLECTION SYSTEM ARE OUTLINED BELOW AND MAY BE USED AS GUIDANCE IN PROPER MAINTENANCE OF THE PROPOSED FACILITIES.
1. REMOVE ALL DEBRIS FROM THE DRAINS, CULVERTS, AND THE OUTLET STRUCTURES.
 2. PIPE OUTFALLS SHALL BE INSPECTED A MINIMUM OF TWO TIMES PER YEAR AND BE KEPT FREE OF DEBRIS AND VEGETATION THAT MAY INTERFERE WITH THE DISCHARGE OF WATER. ROCK TO BE REPLACED AS NEEDED TO PREVENT EROSION AND SCOUR AROUND THE OUTFALL.
 3. PARKING LOTS AND ROADWAYS SHALL BE SWEEPED ON A REGULAR BASIS.
 4. SEDIMENT AND DEBRIS SHALL BE DISPOSED OF AT AN APPROPRIATE LOCATION. UNDER NO CIRCUMSTANCE SHALL SEDIMENT BE DISPOSED OF, IN OR NEAR, WATERS OF THE COMMONWEALTH.
 5. SLOPES AND INLET/OUTLET STRUCTURES SHALL BE INSPECTED FOR EROSION A MINIMUM OF TWO TIMES PER YEAR. VEGETATION TO BE STABILIZED AS NEEDED.
 6. LIMIT USE OF DEICING SALTS IN AREAS THAT DRAIN TO BIORETENTION AREAS.
 7. BIORETENTION AREAS SHOULD BE INSPECTED FOR AND CLEANED OF DEBRIS AND LITTER ON A MONTHLY BASIS.
 8. VEGETATION SHOULD BE STABILIZED AS NEEDED. DETRITUS SHOULD BE REMOVED ON A YEARLY BASIS. PERENNIAL PLANTINGS MAY BE CUT DOWN AT THE END OF THE GROWING SEASON.
 9. MULCHED AREAS SHOULD BE RE-SPREAD IF EROSION IS EVIDENT.
 10. FERTILIZER AND PESTICIDE USE SHOULD BE AVOIDED.
 11. DURING PERIODS OF EXTENDED DROUGHT, BIORETENTION AREAS MAY NEED WATERING.

APPLICANT
 DEPARTMENT OF CONSERVATION AND NATURAL RESOURCES
 OFFICE OF CONSERVATION AND ENGINEERING SERVICES
 400 MARKET STREET, P.O. BOX 8451
 HARRISBURG, PA 17105-8451

NOTES

1. EXISTING CONDITIONS AS DEPICTED ON THESE PLANS ARE GENERAL AND ILLUSTRATIVE IN NATURE. IT IS THE RESPONSIBILITY OF THE CONTRACTOR TO EXAMINE THE SITE AND BE FAMILIAR WITH EXISTING CONDITIONS PRIOR TO BIDDING ON THIS PROJECT. IF CONDITIONS ENCOUNTERED DURING EXAMINATION ARE SIGNIFICANTLY DIFFERENT THAN THOSE SHOWN, THE CONTRACTOR SHALL NOTIFY THE DEPARTMENT IMMEDIATELY.
2. ALL EXISTING ABOVE AND BELOW GROUND STRUCTURES WITHIN THE LIMITS OF CONSTRUCTION SHALL BE REMOVED UNLESS NOTED OTHERWISE WITHIN THIS CONSTRUCTION SET AND/OR PROJECT SPECIFICATIONS. THIS INCLUDES FOUNDATION SLABS, WALLS AND FOOTINGS. IN ADDITION, ALL EXISTING UTILITY SERVICES TO BUILDINGS SHALL BE DISCONNECTED AND TERMINATED PER EACH UTILITY COMPANY'S REQUIREMENTS.
3. ALL WORK PERFORMED BY THE CONTRACTOR SHALL CONFORM TO THE LATEST REGULATIONS OF THE AMERICANS WITH DISABILITIES ACT. CONTRACTOR SHALL ALSO CONTACT PENNSYLVANIA ONE CALL SYSTEM, INC. AT 800-242-1776 AND THE APPROPRIATE UTILITY COMPANIES AT LEAST THREE (3) DAYS PRIOR TO THE INITIATION OF EARTH MOVING AND DEMOLITION ACTIVITIES.
4. THE CONTRACTOR SHALL INDEMNIFY AND HOLD HARMLESS THE DEPARTMENT FOR ANY AND ALL INJURIES AND/OR DAMAGES TO PERSONNEL, EQUIPMENT AND/OR EXISTING FACILITIES OCCURRING IN THE COURSE OF THE DEMOLITION AND CONSTRUCTION DESCRIBED IN THE PLANS AND SPECIFICATIONS.
5. PROJECT LIMIT LINE IS DEFINED IN THE APPROVED EROSION AND SEDIMENTATION CONTROL PLAN. SEE SHEET C9.0-C9.5
6. ALL WORK BY .1 CONTRACTOR UNLESS OTHERWISE NOTED.

REFERENCES

1. EXISTING TOPOGRAPHY PREPARED BY NOR EAST MAPPING, INC. JOB# MEM8006 DATE OF PHOTOGRAPHY: JAN 31, 2008 BALDEAGLE.DWG
2. EXISTING SUBSURFACE SANITARY SEWER INFORMATION INTERPRETED FROM DRAWING TITLED SANITARY SEWER REHABILITATION BALD EAGLE STATE PARK PLAN AND DETAIL FROM PROJECT NO. MM 91-6133A DATED SEP 1991
3. EXISTING SUBSURFACE WATER LINE AND ELECTRIC LINE INFORMATION INTERPRETED FROM DRAWING TITLED FOSTER JOSEPH SAVERS RESERVOIR SANITARY SYSTEMS FOR PUBLIC USE FACILITIES BALD EAGLE STATE PARK GENERAL PLAN DATED SEP 1973

ONE CALL SERIAL NO.: 0925482

CALL BEFORE YOU DIG!
 PENNSYLVANIA LAW REQUIRES 3 WORKING DAYS NOTICE FOR CONSTRUCTION PHASE AND 10 WORKING DAYS IN DESIGN STAGE-STOP CALL PENNSYLVANIA ONE CALL SYSTEM, INC. 1-800-242-1776

PENNSYLVANIA ACT 38 (1991) REQUIRES NO LESS THAN 3 WORKING DAYS NOTICE NOR MORE THAN 10 WORKING DAYS NOTICE FROM EXCAVATORS WHO ARE ABOUT TO DIG, DRILL, BLAST, AUGER, BORE, BRIDGE, TRENCH, OR DEMOLISH ANY IN THE CONSTRUCTION PHASE. FOR LOCATION REQUESTS IN THE STATE OF PENNSYLVANIA CALL TOLL FREE 1-800-242-1776. UNDERGROUND UTILITIES HAVE BEEN PLOTTED FROM AVAILABLE INFORMATION AND THE LOCATION MUST BE CONSIDERED APPROXIMATE. OTHER UNDERGROUND UTILITIES MAY EXIST WHICH ARE NOT SHOWN. IT WILL BE THE CONTRACTOR'S RESPONSIBILITY TO ASCERTAIN ALL PHYSICAL LOCATIONS OF UTILITY LINES PRIOR TO THE TIME OF CONSTRUCTION. IN NO WAY SHALL THE CONTRACTOR HOLD THE SURVEYOR RESPONSIBLE FOR ANY UTILITY LOCATION SHOWN ON THIS PLAN.

C&E
Civil & Environmental Consultants, Inc.
 333 Baldwin Road - Pittsburgh, PA 15205-9072
 Ph: 412.429.2324 - 800.365.2324 - Fax: 412.429.2114
 www.cecinc.com

PROJECT NUMBER
070-915

NO.	DATE	REVISION	APPR.
1	09/08/08	ISSUED FOR ADDENDUM	
SUBMITTED			
PROJECT DESIGNER		PROJECT COORDINATOR	
APPROVED			
CHIEF - CREATION OF DESIGN			
APPROVED			
DIRECTOR - BUREAU OF FACILITY DESIGN AND CONSTRUCTION			

AS-BUILT
 THIS RECORD DRAWING HAS BEEN PREPARED ON INFORMATION PROVIDED BY OTHERS. THE DESIGN PROFESSIONAL HAS NOT VERIFIED THE ACCURACY AND/OR COMPLETENESS OF THIS INFORMATION AND SHALL NOT BE RESPONSIBLE FOR ANY ERRORS OR OMISSIONS WHICH MAY BE INCORPORATED HEREIN AS A RESULT.

COMMONWEALTH OF PENNSYLVANIA
 DEPARTMENT OF CONSERVATION AND NATURAL RESOURCES
 OFFICE OF PARKS AND FORESTRY

PROJECT NO: FDC-133-4494

APPLICABLE CONTRACT NO'S.

GENERAL: FDC-133-4494.1	PLUMBING: FDC-133-4494.3
HVAC: ROADWAY:	ELECTRICAL:

**THE INN AT BALD EAGLE STATE PARK
 HOWARD AND LIBERTY TOWNSHIP,
 CENTRE COUNTY, PENNSYLVANIA**

ENLARGED DRAINAGE PLAN

DRAWN BY: TAF	DATE: 09/18/08	DRAWING NO: C4.0
CHECKED BY: MWT	SCALE: 1"=30'	

G:\Projects\2007\070-915\dwg\AS BUILT\SD070-915-C40.dwg, C40, 10/20/10 10:00:32 AM, krampton

* SIGNATURE OR FILE